

STATE CORPORATION COMMISSION OF KANSAS  
OIL & GAS CONSERVATION DIVISION  
WELL COMPLETION OR RECOMPLETION FORM  
ACO-1 WELL HISTORY  
DESCRIPTION OF WELL HISTORY

S.C.

Operator: License # 5208  
Name MOBIL OIL CORPORATION  
Address P.O. BOX 5444  
City/State/Zip DENVER, COLORADO 80217

Purchaser PERMIAN CORPORATION  
9810 E. 42ND, STE. 233  
TULSA, OK 74145

Operator Contact Person B. R. MAYNARD  
Phone (303) 298-2069

Contractor: License # 9137  
Name UNIT DRILLING & EXPLORATION CO.

Wellsite Geologist J. PHILLIPS  
Phone (303) 298-3653

Designate Type of Completion  
 XX New  Re-Entry  Workover

XX Oil  SMD  Temp Abd  
 Gas  Inj  Delayed Comp.  
 Dry  Other (Core, Water Supply, etc.)

If OWMO: old well info as follows;  
Operator \_\_\_\_\_  
Well Name \_\_\_\_\_  
Coap. Date \_\_\_\_\_

WELL HISTORY

Drilling Method:  
 XX Mud Rotary  Air Rotary  Cable

5-18-88 5-24-88 6-20-88  
Spud Date Date Reached TD Completion Date

6240' 6216'  
Total Depth PBD

Amount of Surface Pipe Set and Cemented at 1725' feet  
Multiple Stage Cementing Collar Used?  XX Yes  No  
If yes, show depth set 3221' feet  
If alternate 2 completion, cement circulated  
from \_\_\_\_\_ feet depth to \_\_\_\_\_ w/ \_\_\_\_\_ SX cat  
Cement Company Name \_\_\_\_\_  
Invoice # \_\_\_\_\_

API No. 15- 189-21176-0000

COUNTY STEVENS

\_\_\_\_\_ East  
SW SE Sec 1 Twp 32S Rge 35 X West

660 Ft North from Southeast Corner of Section  
1980 Ft West from Southeast Corner of Section  
(Note: Locate well in section plat below)


Lease Name CLAUDE D. DAVIS WELL # 2

Field Name LARRABEE

Producing Formation CHESTER

Elevation: Ground 2938' KB 2954'

SECTION PLAT

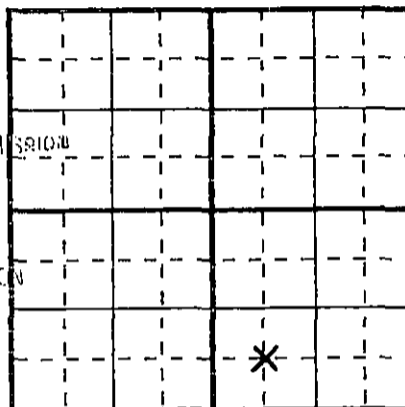

WATER SUPPLY INFORMATION

Disposition of Produced Water:  XX Disposal  
Docket # CD-82408  Repressuring

Questions on this portion of ACO-1 call:  
Water Resources Board (913) 296-3717

Source of Water:  
Division of Water Resources Permit# T88-322

XX Groundwater 690 Ft. North from Southeast Corner  
(well) 4800 Ft. West from Southeast Corner of  
Sec 1 Twp 32S Rge 35 East X West

Surface Water \_\_\_\_\_ Ft. North from Southeast Corner  
(Stream, pond etc) \_\_\_\_\_ Ft. West from Southeast Corner  
Sec \_\_\_\_\_ Twp \_\_\_\_\_ Rge \_\_\_\_\_ East \_\_\_\_\_ West

Other (explain) \_\_\_\_\_  
(purchased from city, R.W.D. #)

INSTRUCTIONS: This form shall be completed in triplicate and filed with the Kansas Corporation Commission, 200 Colorado Derby Building, Wichita, Kansas 67202, within 120 days of the spud date of any well. Rule 82-3-130, 82-3-107, and 82-3-106 apply.

Information on side two of this form will be held confidential for a period of 12 months if requested in writing and submitted with the form. See rule 82-3-107 for confidentiality in excess of 12 months.  
One copy of all wireline logs and drillers time log shall be attached with this form. Submit cp-4 form with all plugged wells. Submit cp-111 form with all temporarily abandoned wells.

All requirements of statutes, rules and regulations promulgated to regulate the oil and gas industry have been fully complied with and the statements herein are complete and correct to the best of my knowledge.

Signature B. R. Maynard B. R. MAYNARD

Title REGULATORY COMPLIANCE MANAGER Date 9-2-88

Subscribed and sworn to before me this 2nd day of Sept.  
Notary Public George J. George  
Date Commission Expires 1/3/91

K.C.C. OFFICE USE ONLY  
 Letter of Confidentiality Attached  
 Wireline Log Received  
 Drillers Timelog Received  
Distribution  
 KCC  SMD/Rep  NGPA  
 KGS  Plug  Other  
(Specify)  
4-9-88