

STATE CORPORATION COMMISSION OF KANSAS
OIL & GAS CONSERVATION DIVISION
WELL COMPLETION OR RECOMPLETION FORM
ACO-1 WELL HISTORY
DESCRIPTION OF WELL AND LEASE

Operator: License # 5208
Name Mobil Oil Corporation
Address P.O. Box 5444
City/State/Zip Denver, CO 80217

Purchaser INFO NOT AVAILABLE AT THIS TIME

Operator Contact Person D. H. Lawrence
Phone 303-298-2698

Contractor: License # 9137
Name UNIT DRILLING & EXPL. CO.

Wellsite Geologist JAN PHILLIPS
Phone 303-298-3653

Designate Type of Completion
 New Well Re-Entry Workover
 Oil Gas Dry
 SWD Inj Temp Abd Delayed Comp. Other (Core, Water Supply etc.)

If ~~OWO~~: old well info as follows:
Operator
Well Name
Comp. Date Old Total Depth

WELL HISTORY

Drilling Method:
 Mud Rotary Air Rotary Cable

9-30-87 10-6-87 10-26-87
Spud Date Date Reached TD Completion Date
6327' 6268'
Total Depth PBTD

Amount of Surface Pipe Set and Cemented at 1786 feet
Multiple Stage Cementing Collar Used? Yes No
If yes, show depth set 3236 ft feet
If alternate 2 completion, cement circulated from feet depth to w/ SX cmt
Cement Company Name
Invoice #

API No. 15-189-21092-0000
County STEVENS
SE SE Sec 2 Twp 32S Rge 35 East West
660 Ft North from Southeast Corner of Section
660 Ft West from Southeast Corner of Section
(Note: Locate well in section plat below)


Lease Name SUSIE TITUS LOGAN Well # 1

Field Name LARRABEE

Producing Formation CHESTER

Elevation: Ground 2973' KB 2984'

Section Plat

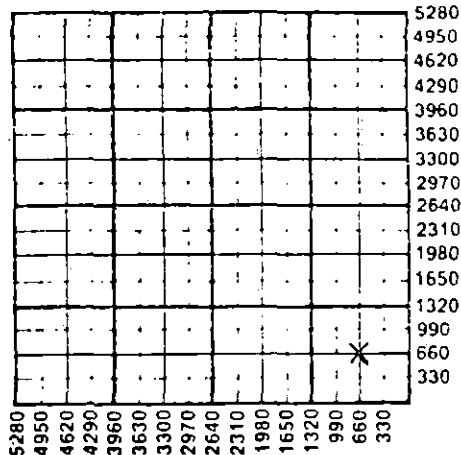

WATER SUPPLY INFORMATION

Disposition of Produced Water: Disposal Repressuring
Docket # INFO NOT AVAILABLE AT THIS TIME

Questions on this portion of the ACO-1 call:

Water Resources Board (913) 296-3717

Source of Water:
Division of Water Resources Permit # T-87-396

Groundwater 690 Ft North from Southeast Corner (Well) 4800 Ft West from Southeast Corner of Sec 1 Twp 32S Rge 35 East West

Surface Water Ft North from Southeast Corner (Stream, pond etc) Ft West from Southeast Corner Sec Twp Rge East West

Other (explain) (purchased from city, R.W.D. #)

INSTRUCTIONS: This form shall be completed in triplicate and filed with the Kansas Corporation Commission, 200 Colorado Derby Building, Wichita, Kansas 67202, within 120 days of the spud date of any well. Rule 82-3-130, 82-3-107 and 82-3-106 apply. Information on side two of this form will be held confidential for a period of 12 months if requested in writing and submitted with the form. See rule 82-3-107 for confidentiality in excess of 12 months. One copy of all wireline logs and drillers time log shall be attached with this form. Submit CP-4 form with all plugged wells. Submit CP-111 form with all temporarily abandoned wells.

All requirements of the statutes, rules and regulations promulgated to regulate the oil and gas industry have been fully complied with and the statements herein are complete and correct to the best of my knowledge.

Signature D. H. Lawrence
Title General Accounting Supervisor Date 11/26/88

Subscribed and sworn to before me this day of 1988
Notary Public
Date Commission Expires

K.C.C. OFFICE USE ONLY
 Letter of Confidentiality Attached
 Wireline Log Received
 Drillers Timelog Received
Distribution
 KCC SWD/Rep NGPA
 KGS Plug Other (Specify)
1-8-88
Form ACO-1 (5-86)

Sec. 2, Twp. 32S, Rge. 35E