


WELL PLUGGING RECORD

Give All Information Completely
Make Required Affidavit
Mail or Deliver Report to:
Conservation Division
State Corporation Commission
211 No. Broadway
Wichita, Kansas

Clark County, Sec. 33 Twp. 31S Rge. 24 (E) (W)

NORTH

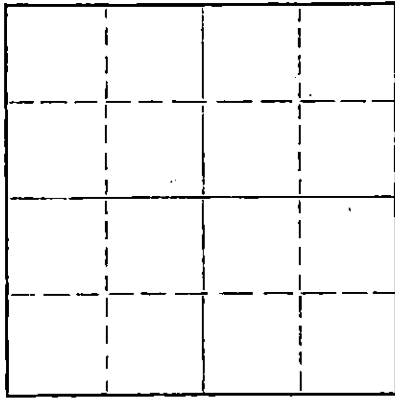

Locate well correctly on above
Section Plat

Location as "NE/CNW%SW%" or footage from lines C NE NE
Lease Owner Musgrove Drilling Company
Lease Name Denton Well No. 1
Office Address 801 Union Center Wichita, Kansas
Character of Well (completed as Oil, Gas or Dry Hole) dry hole
Date well completed July 26, 1961 19
Application for plugging filed _____ 19
Application for plugging approved _____ 19
Plugging commenced July 26, 1961 19
Plugging completed July 26, 1961 19
Reason for abandonment of well or producing formation Dry

If a producing well is abandoned, date of last production _____ 19
Was permission obtained from the Conservation Division or its agents before plugging was commenced? _____

Name of Conservation Agent who supervised plugging of this well _____
Producing formation _____ Depth to top _____ Bottom _____ Total Depth of Well _____ Feet
Show depth and thickness of all water, oil and gas formations.

OIL, GAS OR WATER RECORDS

CASING RECORD

FORMATION	CONTENT	FROM	TO	SIZE	PUT IN	PULLED OUT
				13 3/8	594'	

Describe in detail the manner in which the well was plugged, indicating where the mud fluid was placed and the method or methods used in introducing it into the hole. If cement or other plugs were used, state the character of same and depth placed, from _____ feet to _____ feet for each plug set.

Filled hole with heavy mud to 500 feet, bridged with wood plug and cemented with 25 sacks. Filled with heavy mud to 40 feet, bridged with wood plug and cemented with 10 sacks to bottom of celler

RECEIVED
STATE CORPORATION COMMISSION

AUG 31 1961 8-31-61

CONSERVATION DIVISION
Wichita, Kansas

(If additional description is necessary, use BACK of this sheet)
Name of Plugging Contractor Earl F. Wakefield
Address 515 Union Center Building

STATE OF Kansas COUNTY OF Sedgewick, ss.
Emil E. Bowers (employee of owner) or (owner or operator) of the above-described well, being first duly sworn on oath, says: That I have knowledge of the facts, statements, and matters herein contained and the log of the above-described well as filed and that the same are true and correct. So help me God.

(Signature) Emil E. Bowers
801 Union Center, Wichita, Mo (Address)

SUBSCRIBED AND SWORN TO before me this 21 st. day of August, 1961

Carolyn T. Luerson
Notary Public.

My commission expires 1-2-65

LEASE: DENTON #1
 OPERATOR: HUSGROVE DRILLING
 CONTRACTOR: EARL P. WARFIELD
 COM: 6-12-61 COMP: 7-26-61

LOCATION: S 13 NE
 SECTION 33-31S-24W
 CLARK COUNTY, KANSAS
 CASING: 13 3/8" Set at 594'

Blue Shale	125
Sand	220
Red Bed	350
Shale	538
Blue Shale	600
Shale	775
Shale - Red	1495
Red and Blue Shale	2085
Shale	2229
Anhydrite	2266
Shale with lime stringers	2372
Anhydrite, Lime and Shale	2584
Shale with lime stringers	2670
Lime, Shale, Anhydrite	2764
Lime and Shale	3125
Shale and Lime	3270
Lime and Shale	3860
Chert lime and Shale	3921
Lime and Shale	4430
Breakers lime and Shale	4570
Lime and Shale	4605
White Lime and Chert	4653
Cherty Lime	4678
Lime and Shale	4750
Cherty Lime	4842
Chert Lime and Shale	4860
Cherty Lime	5414
Chalky Lime and Shale & Chert	5431
Lime and Shale	5465
Lime	5475
Lime and Shale	5524
Lime	5551
Lime and Shale	5566
Shale and Lime	5573
Lime and Shale	5625
Shale and Lime	5632
Lime and Shale	5678
Chalky Lime and Shale	5725
Lime and Shale	5734
Shale and Lime	5761
Cherty Lime	6292
Chalky-Cherty Lime	6334
Cherty Lime	6433
Sand and Cherty Lime	6446
Cherty Lime	6479
Chalky and Cherty Lime	6524
Cherty Lime	6573
Hard Lime and Chert	6592
Lime and Chert	6613
Cherty Lime	6663
Lime and Chert	6689
Cherty Lime	6717
Lime and Chert	6745
Chert and Lime	6754
Shale and Cherty Lime	6794
Shale, Lime and Sand	6831
Arbuckle	6871
Lime and Shale	6881
T.D.	6881

RECEIVED
 STATE COMMISSION

JUL 1 1961

CONSERVATION DIVISION
 Wichita, Kansas

DENTON #1
Section 33-318-24W
Clark County, Kansas

PAGE -2-

STATE OF KANSAS)
) SS.
COUNTY OF SEDGWICK)

I hereby certify that the above is a true and correct copy of
the log on the DENTON #1 well, located C NE NE of SECTION 33-318-24W
CLARK COUNTY, KANSAS.

EARL P. WAKEFIELD

By Fred S. Barber

Subscribed and sworn before me this 4th day of August, 1961

My commission expires:

Kenneth E. Lockson

September 12, 1964

NOTARY