

STATE OF KANSAS
STATE CORPORATION COMMISSION


15-077-20473-0000

WELL PLUGGING RECORD

Give All Information Completely
Make Required Affidavit
Mail or Deliver Report to
Conservation Division
State Corporation Comm.
245 North Water
Wichita, KS 67202

Harper County, Sec. 34 Twp. 31 Rge. 5W E/W
Location as "NE/CNW $\frac{1}{4}$ /SW $\frac{1}{4}$ " or footage from lines
SW SW NW

Lease Owner Don Ash
Lease Name Paul Adams Well No. 1
Office Address 8108 E. Gilbert, Wichita, Ks.
Character of Well (Completed as Oil, Gas or Dry Hole)
Dry Hole

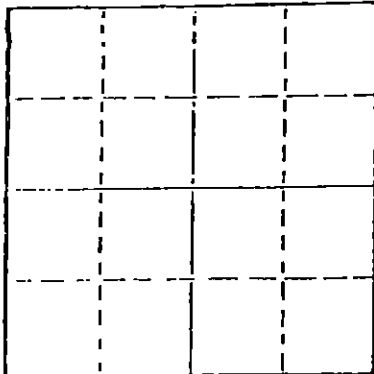

Locate well correctly on above
Section Plot

Date Well completed March 17, 1978 19
Application for plugging filed March 17, 1978 19
Application for plugging approved March 17, 1978 19
Plugging commenced March 17, 1978 19
Plugging completed March 17, 1978 19
Reason for abandonment of well or producing formation
Dry Hole

If a producing well is abandoned, date of last production
19

Was permission obtained from the Conservation Division or
its agents before plugging was commenced?

Name of Conservation Agent who supervised plugging of this well
Producing formation Depth to top Bottom Total Depth of Well
Show depth and thickness of all water, oil and gas formations.

OIL, GAS OR WATER RECORDS

CASING RECORD

FORMATION	CONTENT	FROM	TO	SIZE	PUT IN	PULLED OUT

Describe in detail the manner in which the well was plugged, indicating where the mud fluid
was placed and the method or methods used in introducing it into the hold. If cement or other
plugs were used, state the character of same and depth placed, from feet to
feet for each plug set.

Set plug @ 270' -Cemented w/40 sx.
Plug @ 40'- cemented w/12 sx.- 3 sx.
cement in rat hole.

(If additional description is necessary, use BACK of this sheet)

Name of Plugging Contractor Blue Streak Drilling, Inc.

STATE OF Kansas COUNTY OF Sedgwick, ss.
Louis Elster (employee of owner) or (owner or operator)
of the above-described well, being first duly sworn on oath, says: That I have knowledge of
the facts, statements, and matters herein contained and the log of the above-described well
as filed and that the same are true and correct. So help me God.

(Signature) Louis Elster
Douglas Bltz - Wichita, Ks.
(Address)

SUBSCRIBED AND SWORN TO before me this 24th day of March, 1978

My commission expires 12-21-79

Alma Mae Hassler
Notary Public.

RECEIVED
STATE CORPORATION COMMISSION

MAR 29 1978

CONSERVATION DIVISION
Wichita, Kansas

DRILLERS LOG

15-077-28173-0000

PAUL ADAMS # 1

CASING RECORD:
237' of 8 5/8"
cemented w/175 sx.

COMPANY: Don Ash
CONTRACTOR: Blue Streak Drllg., Inc.
COMMENCED: Mar. 7, 1978
COMPLETED: Mar. 17, 1978

DESCRIPTION:
SW SW NW-
Sec. 34-31S-5W
Harper Co., Ks.

TOTAL DEPTH:
3880'

ELEVATION:
1323 Gr.

<u>FORMATION</u>	<u>FROM</u>	<u>TO</u>	<u>REMARKS</u>
Shale & Lime Stks.	0	787	
Shale & Lime Stks.	787	1282	
Shale & Lime	1282	1714	
Lime & Shale	1714	1915	
Shale & Lime Stks.	1915	2402	
Shale & Lime	2402	2744	
Shale & Lime	2744	3134	
Shale & Lime	3134	3251	
Shale, Lime & Sand	3251	3457	
Shale & Lime	3457	3561	
Lime w/Shale & Sand	3561	3643	
Lime	3643	3766	
Lime & Sand	3766	3800	Total Depth
Total Depth	3800		

I certify that this is a true and correct copy of the above log to the best of my knowledge.

BLUE STREAK DRILLING INC


LOUIS ELSTER

Subscribed and sworn to before me this 24th day of March, 1978


Notary Public Alma Mae Hassler

My Commission Expires: 12-21-79

RECEIVED
STATE CORPORATION COMMISSION

MAR 29 1978

CONSERVATION DIVISION
Wichita, Kansas