

Give all information Completely
Make Required Affidavit
Mail or Deliver Report to:
Conservation Division
State Corporation Commission
212 No. Market
Wichita, Kansas

WELL PLUGGING RECORD

Harper

County. Sec. 34 Twp. 31S Rge. (E) 5 (W)

Location as "NE/CNW/SW" or footage from lines. 150 So. of C NW SW

Lease ~~Owner~~ Operator Keener Oil Company

Lease Name Schenck Well No. 2

Office Address 406 National Bank of Tulsa Bldg., Tulsa, Okla. 74103

Character of Well (completed as Oil, Gas or Dry Hole) Dry Hole

Date well completed 9/6 19 71

Application for plugging filed by telephone 9/6 19 71

Application for plugging approved 9/8 19 71

Plugging commenced 9/6 19 71

Plugging completed 9/6 19 71

Reason for abandonment of well or producing formation Dry Hole

If a producing well is abandoned, date of last production - 19

Was permission obtained from the Conservation Division or its agents before plugging was commenced? Yes

Name of Conservation Agent who supervised plugging of this well Mr. Russell Biberstein

Producing formation Simpson Depth to top 4654 Bottom 4704 Total Depth of Well 4704 Feet

Show depth and thickness of all water, oil and gas formations.

OIL, GAS OR WATER RECORDS

CASING RECORD

FORMATION	CONTENT	FROM	TO	SIZE	PUT IN	PULLED OUT
Stalnaker	Oil & Water	3318	3336	8 5/8		None
Simpson	Dry	4654	4704			

Describe in detail the manner in which the well was plugged, indicating where the mud fluid was placed and the method or methods used in introducing it into the hole. If cement or other plugs were used, state the character of same and depth placed, from _____ feet to _____ feet for each plug set.

Hole filled w/heavy rotary mud. Spotted 25 sx. regular cement thru drill pipe @ 3200 ft.

Spotted 30 sx. regular cement thru drill pipe @ 600 ft.

Plug @ .40 ft. w/ 1/2 sack hulls and 10 sx. reg. cement. 2 sacks cement placed in rat hole.

RECEIVED
STATE CORPORATION COMMISSION
SEP 16 1971
CONSERVATION DIVISION
Wichita, Kansas

(If additional description is necessary, use BACK of this sheet)

Name of Plugging Contractor Gabbert-Jones, Inc.

Address 830 Sutton Place, Wichita, Kansas 67202

STATE OF Oklahoma, COUNTY OF Tulsa, ss.
F. W. Weaver

(employee of owner) or (owner or operator) of the above-described well, being first duly sworn on oath, says: That I have knowledge of the facts, statements, and matters herein contained and the log of the above-described well as filed and that the same are true and correct. So help me God.

(Signature) F. W. Weaver


406 N.B.T. Bldg., Tulsa, Oklahoma 74103

(Address)

SUBSCRIBED AND SWORN TO before me this 13th day of September, 19 71

My commission expires June 4, 1972

Notary Public.

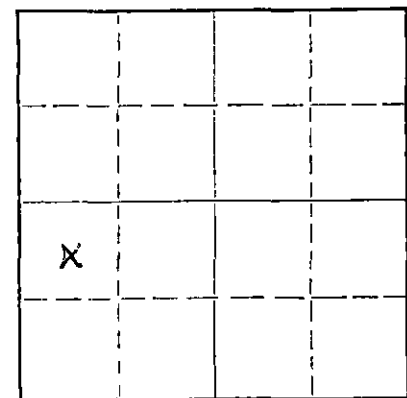

Locate well correctly on above Section Plat

GABBERT-JONES, INC.
 WICHITA, KANSAS
 DRILLERS' WELL LOG

15-077-20130-0003

SCHENCK #2
 NW SW, Sec. 34-31S-5W
 Harper County, Kansas

Commenced: August 25, 1971
 Completed: September 6, 1971

OPERATOR: Keener Oil Company

DEPTH		FORMATION	REMARKS
From	To		
0	40	Clay and Sand	Ran 11 joints of used 8 5/8" 28# casing. Set @ 238' cemented w/200 sks common. 2% Gel-3% CC P.D. @ 10:15 PM 8/25/71 Cement Circ. Job by Halco. Centralizer 5' below collar on shoe joint.
40	239	Redbed	
239	425	Redbed and Shale	
425	810	Shale and Shells	
810	888	Shale	
888	1438	Shale and Lime	
1438	1749	Lime and Shale	
1749	3154	Shale and Lime	
3154	3336	Shale and Sand	
3336	3400	Sand	
3400	3703	Shale and Lime	Dry and Abandoned
3703	4604	Lime	
4604	4654	Shale	
4654	4671	Sand	
4671	4701	Sand	
4701	4704	Shale	
4704	TD		

RECEIVED
 STATE CORPORATION COMMISSION
 SEP 16 1971
 CONSERVATION DIVISION
 Wichita, Kansas

I, James S. Sutton, certify this is a correct copy of the Drillers' Log for the well drilled in the C SE SW, Section 17-32S-5W, Harper County, Kansas, to the best of my knowledge and belief.

James S. Sutton II
 James S. Sutton II

STATE OF KANSAS)
) SS
 COUNTY OF SEDGWICK)

Before me, the undersigned, a Notary Public within and for said County and State, on this 9th day of September, 1971, personally appeared James S. Sutton II to me personally known to be the identical person who executed the within and foregoing instrument and acknowledged to me that he executed the same as his free and voluntary act and deed for the uses and purposes therein set forth.

IN WITNESS WHEREOF, I have hereunto set my hand and official seal the day and year last above written.

Marjorie Hall
 Marjorie Hall, Notary Public

My commission expires
 Nov. 29, 1971