


15-119-26224-6000

STATE OF KANSAS
STATE CORPORATION COMMISSION
CONSERVATION DIVISION
P. O. BOX 17027
WICHITA, KANSAS 67217

FORM CP-4

WELL PLUGGING RECORD

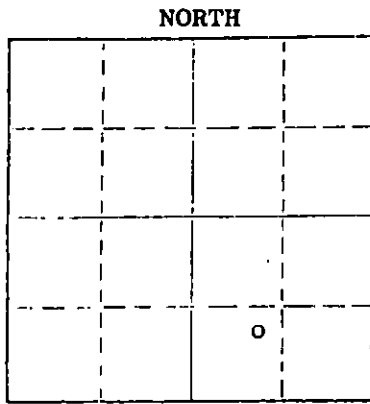

Locate well correctly on above Section Plat

Meade County, Sec. 16 Twp. 31S Rge. 28 (X) (W)
Location as "NE/CNW/SW" or footage from ^{Appl. E/A} SW SE
Lease Owner Woods Petroleum Corporation
Lease Name Wilson Well No. 16-1
Office Address Suite 500, 3555 N.W. 58th, Okla. City, OK 73112
Character of Well (completed as Oil, Gas or Dry Hole) Oil Well
Date well completed June 20 19 76
Application for plugging filed Feb. 10 19 77
Application for plugging approved Feb. 14 19 77
Plugging commenced 19
Plugging completed Feb. 18 19 77
Reason for abandonment of well or producing formation Depleted
If a producing well is abandoned, date of last production December 19 76
Was permission obtained from the Conservation Division or its agents before plugging was commenced? Yes

Name of Conservation Agent who supervised plugging of this well
Producing formation Marmaton Depth to top 5136 Bottom 5144 Total Depth of Well 5800 Feet
Show depth and thickness of all water, oil and gas formations. 4940 4948' (non-productive)
4718 4720' (non-productive)

OIL, GAS OR WATER RECORDS CASING RECORD

FORMATION	CONTENT	FROM	TO	SIZE	PUT IN	PULLED OUT
				8 5/8"	1445'	
				4 1/2"	5297'	

Describe in detail the manner in which the well was plugged, indicating where the mud fluid was placed and the method or methods used in introducing it into the hole. If cement or other plugs were used, state the character of same and depth placed, from feet to feet for each plug set.

Set 25 sacks cement at 4552', shot pipe off at 3115', and pulled 79 jts. casing. Displaced 50 sacks plug from 1495-1395', spotted 10 sacks from 4-34'. Welded on plate with proper identification.

Name of Plugging Contractor Lillard Casing Pullers (If additional description is necessary, use BACK of this sheet)
Address P. O. Box 962, Woodward, Oklahoma 73801
FEB 24 1977
2-24-77
Conservation Division
Wichita, Kansas

STATE OF Oklahoma COUNTY OF Oklahoma ss.
C. T. Pore (employee of owner) or (owner or operator) of the above-described

well, being first duly sworn on oath, says: That I have knowledge of the facts, statements, and matters herein contained and the log of the above-described well as filed and that the same are true and correct. So help me God.

(Signature) [Signature] S-500, 3555 N.W. 58th, Okla., City, OK 73112 (Address)

Subscribed and sworn to before me this 21st day of February 1977

My commission expires 12/6/77

