


Give All Information Completely
Make Required Affidavit
Mail or Deliver Report to:
Conservation Division
State Corporation Commission
211 No. Broadway
Wichita, Kansas

WELL PLUGGING RECORD

Meade County, Sec. 7 Twp. 31s Rge. 29w (E) (W)

Location as "NE/CNW&SW%" or footage from lines _____
Lease Owner Wm. Gruenerwald AND Associates
Lease Name Miles Well No. 1
Office Address 35 EAST WACKER DR. Chicago Ill.
Character of Well (completed as Oil, Gas or Dry Hole) Gas well + some oil
Date well completed (Approximately) 4-18 1958
Application for plugging filed 4-18 1963
Application for plugging approved Oral 1963
Plugging commenced 4-19 1963
Plugging completed 4-22 1963
Reason for abandonment of well or producing formation Marginal well

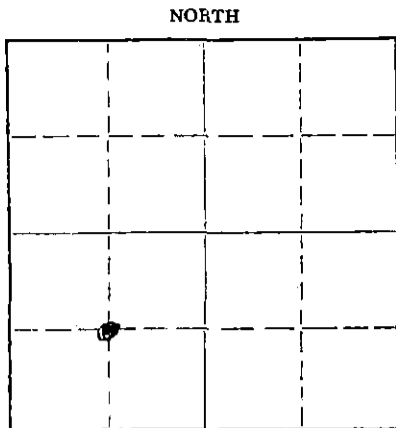

Locate well correctly on above Section Plat

If a producing well is abandoned, date of last production 4-18 1963

Was permission obtained from the Conservation Division or its agents before plugging was commenced? yes

Name of Conservation Agent who supervised plugging of this well Hugh Scott

Producing formation Lower marvau Depth to top 5440 Bottom 5476 Total Depth of Well 5485 Feet

Show depth and thickness of all water, oil and gas formations.

OIL, GAS OR WATER RECORDS

CASING RECORD

FORMATION	CONTENT	FROM	TO	SIZE	PUT IN	PULLED OUT
<u>Marvau</u>	<u>Gas</u>	<u>5440</u>	<u>5476</u>	<u>8 3/4</u> <u>5 1/2</u>	<u>1673</u> <u>5485</u>	<u>None</u> <u>3542</u>

Describe in detail the manner in which the well was plugged, indicating where the mud fluid was placed and the method or methods used in introducing it into the hole. If cement or other plugs were used, state the character of same and depth placed, from _____ feet to _____ feet for each plug set.

Pumped with pump Truck 20 SKs cement 5485 to 5335 mud 5335 to 700
3 Pumped 35 SKs cement 700 to 600 mud 600 to 40
pumped 15 SKs 40 to 0 and wels cap on 8 3/4 cut 8 3/4 off 4' below ground level

RECEIVED
STATE CORPORATION COMMISSION

APR 25 1963

CONSERVATION DIVISION
Wichita, Kansas

(If additional description is necessary, use BACK of this sheet)

Name of Plugging Contractor SARGENTS CASING Pulling Service
Address 121 West 19th

STATE OF KANSAS, COUNTY OF SEWARD, ss.

(employee of owner) or (owner or operator) of the above-described well, being first duly sworn on oath, says: That I have knowledge of the facts, statements, and matters herein contained and the log of the above-described well as filed and that the same are true and correct. So help me God.

(Signature) Robert Sargent

(Address) _____

SUBSCRIBED AND SWORN TO before me this 24 day of April, 1963

My commission expires 11-5-66

Walter Kealey
Notary Public.



MILES #1

WELL RECORD

LOCATION: SE/4 Sec. 7-T31S-R29W
Meade County, Kansas

Commenced: 3/20/58
Completed: 4/12/58
(Rotary)

OPERATOR: Graham-Michaelis Drlg. Co.
211 North Broadway
Wichita, Kansas

15A 10084-00-00
119

CONTRACTOR: Graham-Michaelis Drlg. Co.
211 North Broadway
Wichita, Kansas

CASING RECORD: 8 5/8" @1673 W/850 sks common cement
5 1/2" @3485' W/325 sks cement

LOG

Red Bed	984
Shale	1071
Shale & Lime	1627
Lime & shale	2717
Lime Chalky & Shale	3332
Lime & Shale	3393
Shale & Lime	3820
Lime & Shale	3975
Lime	4814
Lime & Shale	4849
Lime	4872
Lime & Shale	5400
Lime, Shale & Sand	5485 RTD

RECEIVED
STATE CORPORATION COMMISSION

OCT 16 1958

CONSERVATION DIVISION
Wichita, Kansas

STATE OF KANSAS)
)ss.
COUNTY OF SEDGWICK)

The undersigned, GRAHAM-MICHAELIS DRILLING COMPANY, hereby certifies that the above log is a true and correct log of the formation encountered in drilling the above well as reflected by the Daily Drilling Report.

GRAHAM-MICHAELIS DRILLING COMPANY

By John L. James
John L. James, Geologist

Subscribed and sworn to before me
this 17th day of April, 1958.

My commission expires 1-7-61