

STATE OF KANSAS  
STATE CORPORATION COMMISSION


15-19-20451-0000

WELL PLUGGING RECORD

Give All Information Completely  
Make Required Affidavit  
Mail or Deliver Report to  
Conservation Division  
State Corporation Comm.  
245 North Water  
Wichita, KS 67202

Meade County, Sec. 20 Twp. 31 Rge. 29 ~~NE~~/W  
Location as "NE/CNW $\frac{1}{2}$ SW $\frac{1}{2}$ " or footage from lines \_\_\_\_\_

C NW NE  
Lease Owner Gruenerwald & Associates  
Lease Name Loether Well No. 1  
Office Address P.O. Box 909, Colo. Spgs, Colo. 80901  
Character of Well (Completed as Oil, Gas or Dry Hole)  
Dry Hole

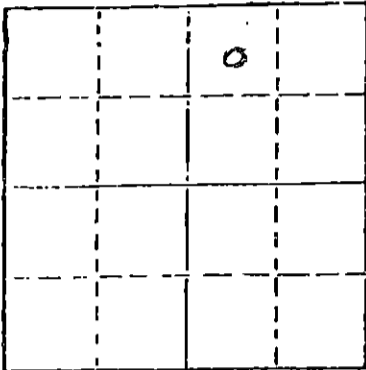

Locate well correctly on above  
Section Plot

Date Well completed January 5 1981  
Application for plugging filed Verbal-January 5 1981  
Application for plugging approved Verbal-January 5 1981  
Plugging commenced January 5 1981  
Plugging completed January 5 1981  
Reason for abandonment of well or producing formation  
Dry Hole

If a producing well is abandoned, date of last production  
N/A 19

Was permission obtained from the Conservation Division or  
its agents before plugging was commenced? Yes

Name of Conservation Agent who supervised plugging of this well Clarence Thomas  
Producing formation None Depth to top -- Bottom -- Total Depth of Well 5981  
Show depth and thickness of all water, oil and gas formations.

OIL, GAS OR WATER RECORDS

CASING RECORD

FORMATION	CONTENT	FROM	TO	SIZE	PUT IN	PULLED OUT
None						

Describe in detail the manner in which the well was plugged, indicating where the mud fluid was placed and the method or methods used in introducing it into the hold. If cement or other plugs were used, state the character of same and depth placed, from \_\_\_\_\_ feet to \_\_\_\_\_ feet for each plug set.

Drilling mud from 5881-1530  
Cement from 1530-1350  
Drilling mud from 1350-800  
Drilling mud from 801-35  
Cement from 35 to surface

All work done with rotary and drill pipe

(If additional description is necessary, use BACK of this sheet)

Name of Plugging Contractor Service Drilling Company

STATE OF Colorado COUNTY OF El Paso, ss.  
A.J. Smith (employee of owner) or ~~(owner)~~

of the above-described well, being first duly sworn on oath, says: That I have knowledge of the facts, statements, and matters herein contained and the log of the above-described well as filed and that the same are true and correct. So help me God.

(Signature) *A.J. Smith*  
A.J. Smith, Production Superintendent  
(Address)

SUBSCRIBED AND SWORN TO before me this 12th day of January, 1981

*Janet B. Fonguel*  
Notary Public.

My commission expires June 12, 1982

RECEIVED  
STATE CORPORATION COMMISSION  
1-14-81  
JAN 14 1981

CONSERVATION DIVISION  
Wichita, Kansas