SIDE ONE

STATE CORPORATION COMMISSION OF KANSAS
OIL & GAS CONSERVATION DIVISION
WELL COMPLETION OR RECOMPLETION FORM
ACO-1 WELL HISTORY
DESCRIPTION OF WELL AND LEASE

API NO. 15- 189-21,280-0000

County: Stevens

SW NE SW Sec. 27 Twp. 32S Rge. 39 ___ East X West

1390 Ft North from Southeast Corner of Section
3890 Ft West from Southeast Corner of Section
(Note: Locate well in section plat below)

Lease Name: Nuss "A" Well # 1H

Field Name: Hugoton

Producing Formation: Chase

Elevation: Ground 3168.9 KB NA

Operator: License # 5598
Name: APX Corporation
Address: P. O. Box 351
City/State/Zip: Liberal, Kansas 67905-0351

Purchaser: Panhandle Eastern Pipe Line Co (Transporter)

Operator Contact Person: M. L Pease
Phone: (316) 624-6253

Contractor: License # 5842
Name: Gabbert-Jones, Inc.

Wellsite Geologist: NA
Phone:

RECEIVED
STATE CORPORATION COMMISSION
2-9-89
1989
CONSERVATION DIVISION
Wichita, Kansas

Section Plat

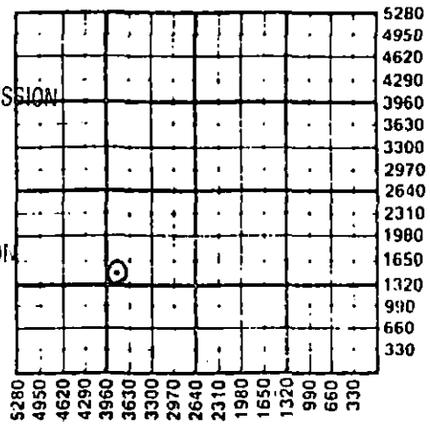


Designate Type of Completion
X New Well ___ Re-Entry ___ Workover
___ Oil ___ SWD ___ Temp Abd
X Gas ___ Inj ___ Delayed Comp.
___ Dry ___ Other (Core, Water Supply etc.)

If OWWO: old well info as follows:
Operator
Well Name
Comp. Date Old Total Depth

WELL HISTORY

Drilling Method:
X Mud Rotary ___ Air Rotary ___ Cable

| 10/20/88 | 10/23/88 | 12/17/88 |
|---|---|---|
| Spud Date | Date Reached TD | Completion Date |

| 2750 | 2739 |
|---|---|
| Total Depth | PBTD |

Amount of Surface Pipe Set and Cemented at 512 feet
Multiple Stage Cementing Collar Used? ___ Yes X No
If yes, show depth set feet
If alternate 2 completion, cement circulated
from feet depth to w/ SX cmt
Cement Company Name Halliburton Services
Invoice # 720621

WATER SUPPLY INFORMATION

Disposition of Produced Water: ___ Disposal
Docket # ___ Repressuring

Questions on this portion of the ACO-1 call:
Water Resources Board (913) 296-3717

Source of Water:
Division of Water Resources Permit #

___ Groundwater Ft North from Southeast Corner
(Well) Ft West from Southeast Corner of
Sec Twp Rge ___ East ___ West

___ Surface Water Ft North from Southeast Corner
(Stream, pond etc) Ft West from Southeast Corner
Sec Twp Rge ___ East ___ West

X Other (explain) Contractor provided water
(purchased from city, R.W.D. #)

INSTRUCTIONS: This form shall be completed in triplicate and filed with the Kansas Corporation Commission, 200 Colorado Derby Building, Wichita, Kansas 67202, within 120 days of the spud date of any well. Rule 82-3-130, 82-3-107 and 82-3-106 apply.
Information on side two of this form will be held confidential for a period of 12 months if requested in writing and submitted with the form. See rule 82-3-107 for confidentiality in excess of 12 months.
One copy of all wireline logs and drillers time log shall be attached with this form. Submit CP-4 form with all plugged wells. Submit CP-111 form with all temporarily abandoned wells.

All requirements of the statutes, rules and regulations promulgated to regulate the oil and gas industry have been fully complied with and the statements herein are complete and correct to the best of my knowledge.

Signature M. L. Pease
M. L Pease
Title Division Production Manager Date 2/7/89

Subscribed and sworn to before me this 8th day of Feb. 19 89
Notary Public Glenna S. Salley

Date Commission Expires GLENNA S. SALLEY NOTARY PUBLIC STATE OF KANSAS MY APPT. EXPIRES 1-6-91

K.C.C. OFFICE USE ONLY
F ✓ Letter of Confidentiality Attached
C ✓ Wireline Log Received
C ___ Drillers Timelog Received
Distribution
✓ KCC ___ SWD/Rep ___ NGPA
✓ KGS ___ Plug ___ Other (Specify)

2-9-89 KCT

Sec. 27 Twp. 32 Rge. 39 W

Form ACO-1 (5-86)