

CARD MUST BE TYPED

NOTICE OF INTENTION TO DRILL

State of Kansas
(see rules on reverse side)

CARD MUST BE SIGNED

Starting Date: October 5, 1985
month day year

OPERATOR: License # 5027
Name J. A. Allison
Address 300 West Douglas, #305
City/State/Zip Wichita, Kansas 67202
Contact Person J. A. Allison
Phone 316-263-2241

CONTRACTOR: License # 5103
Name Union Drilling Company, Inc.
City/State Wichita, Kansas 67202

Well Drilled For:		Well Class:	Type Equipment:
<input type="checkbox"/> Oil	<input type="checkbox"/> Swd	<input type="checkbox"/> Infield	<input checked="" type="checkbox"/> Mud Rotary
<input checked="" type="checkbox"/> Gas	<input type="checkbox"/> Inj	<input checked="" type="checkbox"/> Pool Ext.	<input type="checkbox"/> Air Rotary
<input checked="" type="checkbox"/> OWWO	<input type="checkbox"/> Expl	<input type="checkbox"/> Wildcat	<input type="checkbox"/> Cable

If OWWO: old well info as follows:

Operator Papke-King & Natl Oil
Well Name #1 Helsel
Comp Date 1-15-72 Old Total Depth 4500
Projected Total Depth 3000 feet
Projected Formation at TD Stotler Lime
Expected Producing Formations Langdon Sand

I certify that we will comply with K.S.A. 55-101, et seq., plus eventually plugging hole to K.C.C. specifications.

Date Sept. 6, 1985 Signature of Operator or Agent

J. A. Allison

API Number 15- 151-20,187-B
C SW NE Sec 18 Twp 28S S, Rge 12 East
(location)

3300 Ft North from Southeast Corner of Section
1980 Ft West from Southeast Corner of Section
(Note: Locate well on Section Plat on reverse side)

Nearest lease or unit boundary line 660 feet.County PRATTLease Name HELSEL "B" Well # 1-ADomestic well within 330 feet: ☐ yes ☒ noMunicipal well within one mile: ☐ yes ☒ noDepth to Bottom of fresh water 215 feetLowest usable water formation Top of PermianDepth to Bottom of usable water 235 feetSurface pipe by Alternate: 1 ☒ 2 ☐Surface pipe be set (already set) 320 feetConductor pipe if any required 10-3/4 @ 320 feetGround surface elevation 1875 feet MSLThis Authorization Expires 3-9-86Approved By 9-9-85


RCH BY KONE

Title Operator

Must be filed with the K.C.C. five (5) days prior to commencing well
This card void if drilling not started within six (6) months of date received by K.C.C.

Important procedures to follow :

**A Regular Section of Land
1 Mile = 5,280 Ft.**

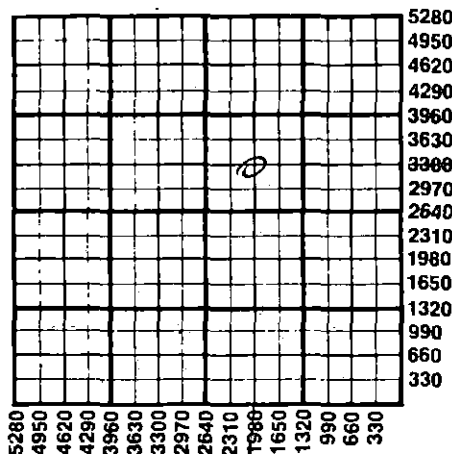

1. Notify District office before setting surface casing.
2. Set surface casing by circulating cement to the top.
3. File completion forms ACO-1 with K.C.C. within 90 days of well completion, following instructions on ACO-1, side 1, and including copies of wireline logs.
4. Notify District office 48 hours prior to old well workover or re-entry.
5. Prior to plugging, prepare a plugging plan, then obtain agreement from the appropriate district office for an approved plugging plan.
6. Submit plugging report (CP-4) to K.C.C. after plugging is completed.
7. Obtain an approved injection docket number before disposing of salt water.
8. Notify K.C.C. within 10 days when injection commences or terminates.
9. If an alternate 2 completion, cement in the production pipe from below any usable water to surface within 120 days of spud date.

State Corporation Commission of Kansas
Conservation Division
200 Colorado Derby Building
Wichita, Kansas 67202
(316) 263-3238