

FOR KCC USE:

P.U. "OWWO"

FORM C-1 7/91

FORM MUST BE TYPED

FORM MUST BE SIGNED

ALL BLANKS MUST BE FILLED

EFFECTIVE DATE: 3-22-92

State of Kansas

DISTRICT #

NOTICE OF INTENTION TO DRILL

SEA7... Yes  No

Must be approved by the K.C.C. five (5) days prior to commencing well

Expected Spud Date March 19, 1992

Spot 50'S of ... Sec 18, Twp 28, S, Rg 12 East

OPERATOR: License # 30510 Sunrise Operating Company

2920' feet from South / North line of Section 330' feet from East / West line of Section

CONTRACTOR: License #: 5142 Sterling Drilling Company

Well Drilled For: Oil, Gas, X. OWWO, Seismic, X Other Storage

IS SECTION X REGULAR IRREGULAR? (NOTE: Locate well on the Section Plat on Reverse Side) County: Pratt Lease Name: BAILEY "OWWO" Well #: 2 Field Name: Konold East

If OWWO: old well information as follows: Operator: J.A. Allison, 300 W. Douglas, Wichita, KS

Directional, Deviated or Horizontal wellbore? ... yes X no

AFFIDAVIT

The undersigned hereby affirms that the drilling, completion and eventual plugging of this well will comply with K.S.A. 55-101, et. seq.

- 1. Notify the appropriate district office prior to spudding of well; 2. A copy of the approved notice of intent to drill shall be posted on each drilling rig;

I hereby certify that the statements made herein are true and to the best of my knowledge and belief.

Date: 3/16/92 Signature of Operator or Agent: Brent B. Reinhardt Title: Geologist

FOR KCC USE: API # 15-151-20, 787-00-02 Conductor pipe required None feet Minimum surface pipe required 200 feet per Alt. Approved by: MW 3-17-92 This authorization expires: 9-17-92

Handwritten initials and date: 85, 3/16/92

RECEIVED KANSAS CORPORATION COMMISSION MAR 16 1992 CONSERVATION DIVISION WICHITA, KS

- REMEMBER TO: - File Drill Pit Application (form CDP-1) with Intent to Drill; - File Completion Form ACD-1 within 120 days of spud date;

Mail to: Conservation Division, 200 Colorado Derby Building, 202 W. First St., Wichita, Kansas 67202-1286.

Handwritten numbers: 18, 28, 1210

IN ALL CASES PLOT THE INTENDED WELL ON THE PLAT BELOW

PLAT OF ACREAGE ATTRIBUTABLE TO A WELL IN A PRORATED OR SPACED FIELD

If the intended well is in a prorated or spaced field, please fully complete this side of the form. If the intended well is in a prorated or spaced field complete the plat below showing that the well will be properly located in relationship to other wells producing from the common source of supply. Please show all the wells within 1 mile of the boundaries of the proposed acreage attribution unit for gas wells and within 1/2 mile of the boundaries of the proposed acreage attribution unit for oil wells.

API NO. 15- \_\_\_\_\_  
OPERATOR Sunrise Operating Company  
LEASE BAILEY  
WELL NUMBER #2 "OWWO"  
FIELD Konold East

LOCATION OF WELL: COUNTY Pratt  
2920 feet from south/~~north~~ line of section  
330 feet from east/~~west~~ line of section  
SECTION 18 TWP 28s RG 12w



NUMBER OF ACRES ATTRIBUTABLE TO WELL 240  
QTR/QTR/QTR OF ACREAGE NE/4 & N2 of SE/4

IS SECTION X REGULAR or IRREGULAR  
IF SECTION IS IRREGULAR, LOCATE WELL FROM NEAREST CORNER BOUNDARY.

Section corner used: NE NW SE SW

PLAT

(Show location of the well and shade attributable acreage for prorated or spaced wells.)  
(Show footage to the nearest lease or unit boundary line.)

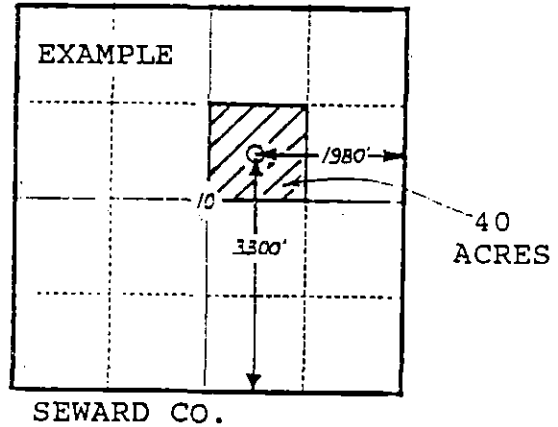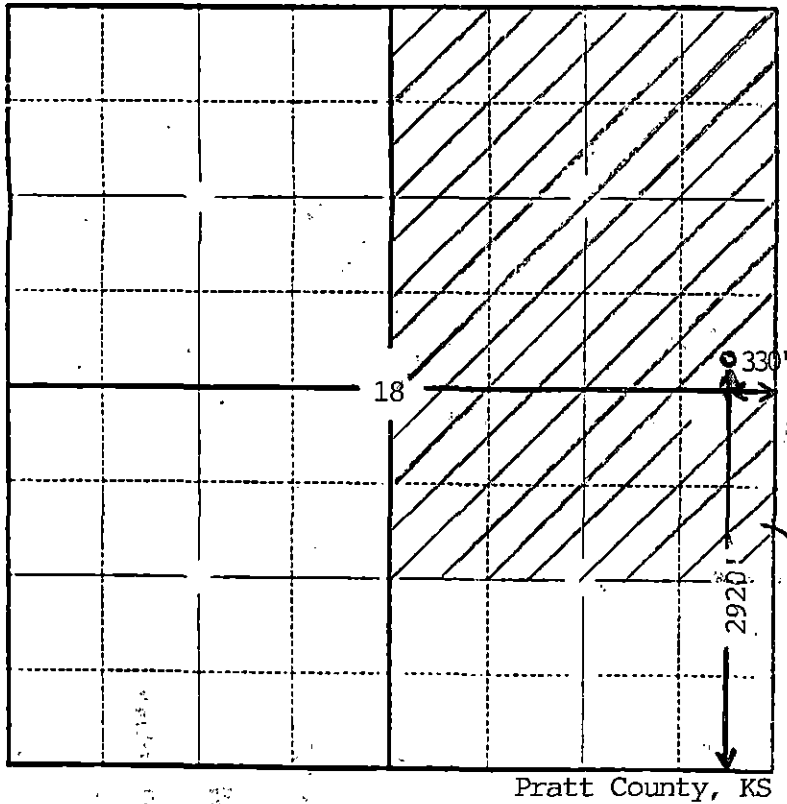

240 acres

Pratt County, KS

In plotting the proposed location of the well, you must show:

- 1) The manner in which you are using the depicted plat by identifying section lines, i.e. 1 section, 1 section with 8 surrounding sections, 4 sections, etc.;
- 2) the distance of the proposed drilling location from the section's south/north and east/west lines; and
- 3) the distance to the nearest lease or unit boundary line.