

CARD MUST BE TYPED

State of Kansas  
**NOTICE OF INTENTION TO DRILL**  
(see rules on reverse side)

(CORRECTED)

9-12-85

CARD MUST BE SIGNED

Starting Date: September 30 1985  
month day year

API Number 15-151-21,701-00100

OPERATOR: License # 5027  
Name J. A. Allison  
Address 300 West Douglas, Suite 305  
City/State/Zip Wichita, Kansas 67202  
Contact Person J. A. Allison  
Phone 316-263-2241

\* C E2 NE SW Sec 18 Twp 28 S, Rge 12  East  
(location)  West

\* 1980 Ft North from Southeast Corner of Section  
2970 Ft West from Southeast Corner of Section  
(Note: Locate well on Section Plat on reverse side)

CONTRACTOR: License # 5103  
Name Union Drilling Company, Inc.  
City/State Wichita, Kansas 67202

Nearest lease or unit boundary line 330 feet.  
County PRATT  
Lease Name HELSEL "D" Well# 1

Well Drilled For: Well Class: Type Equipment:  
 Oil  Swd  Infld  Mud Rotary  
 Gas  Inj  Pool Ext.  Air Rotary  
 OWWO  Expl  Wildcat  Cable

Domestic well within 330 feet:  yes  no  
Municipal well within one mile:  yes  no

If OWWO: old well info as follows:

Operator .....  
Well Name .....  
Comp Date ..... Old Total Depth .....  
Projected Total Depth 2950 feet  
Projected Formation at TD Stotler Lime  
Expected Producing Formations Langdon Sand

Depth to Bottom of fresh water 215 feet  
Lowest usable water formation Top of Permian  
Depth to Bottom of usable water 235 feet  
Surface pipe by Alternate: 1  2   
Surface pipe to be set 245 feet  
Conductor pipe if any required 13-3/8" @ 245 feet  
Ground surface elevation 1878 feet MSL  
This Authorization Expires 3-9-86  
Approved By 9-9-85

I certify that we will comply with K.S.A. 55-101, et seq. plus eventually plugging hole to K.C.C. Specifications.

was NE NE SW 2310 FSL

Date Sept. 11, 1985 Signature of Operator or Agent

*J. A. Allison*  
J. A. Allison


Title Operator

CONSERVATION DIVISION  
Wichita, Kansas

Must be filed with the K.C.C. five (5) days prior to commencing well  
This card void if drilling not started within six (6) months of date received by K.C.C.

SEP 12 1985  
58-21-95

STATE CORPORATION COMMISSION  
A Regular Section of Land  
1 Mile = 5,280 Ft.

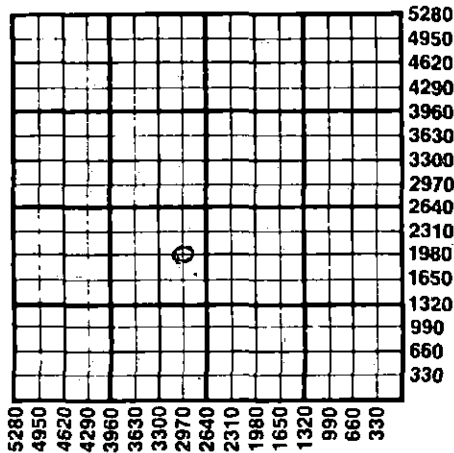

**Important procedures to follow:**

1. Notify District office before setting surface casing.
2. Set surface casing by circulating cement to the top.
3. File completion forms ACO-1 with K.C.C. within 90 days of well completion, following instructions on ACO-1, side 1, and including copies of wireline logs.
4. Notify District office 48 hours prior to old well workover or re-entry.
5. Prior to plugging, prepare a plugging plan, then obtain agreement from the appropriate district office for an approved plugging plan.
6. Submit plugging report (CP-4) to K.C.C. after plugging is completed.
7. Obtain an approved injection docket number before disposing of salt water.
8. Notify K.C.C. within 10 days when injection commences or terminates.
9. If an alternate 2 completion, cement in the production pipe from below any usable water to surface within 120 days of spud date.

State Corporation Commission of Kansas  
Conservation Division  
200 Colorado Derby Building  
Wichita, Kansas 67202  
(316) 263-3238