

This form shall be filed in duplicate with the Kansas Corporation Commission, 200 Colorado Derby Building, Wichita, Kansas 67202, within ten days after the completion of the well, regardless of how the well was completed.

Attach separate letter of request if the information is to be held confidential. If confidential, only file one copy. Information on side one will be of public record and side two will then be held confidential.

Circle one: Oil, Gas, Dry, SWD, OWWO, Injection. Type and complete ALL sections. Applications must be filed for dual completion, commingling, SWD and injection, T.A.

Attach wireline logs (i.e. electrical log, sonic log, gamma ray neutron log, etc.). KCC # (316) 263-3238. (Rules 82-2-105 & 82-2-125)

OPERATOR Associated Petroleum Consultants, Inc.
ADDRESS Suite 600 - One Main Place
Wichita, KS 67202-1399

API NO. 15-151-21,101-00-00
COUNTY Pratt
FIELD Brant (Extension)

\*\*CONTACT PERSON Phyllis Buchanan
PHONE (316) 265-9385

PROD. FORMATION Indian Cave


PURCHASER Central States Gas Company
ADDRESS 1700 Broadway
Denver, CO 80290

LEASE Dudrey
WELL NO. #1
WELL LOCATION C E/2 W/2 SE/4

DRILLING Trans-Pac Drilling, Inc.
CONTRACTOR
ADDRESS Suite 600 - One Main Place
Wichita, KS 67202-1399

1320' Ft. from South Line and
1650' Ft. from East Line of
the SE/4 SEC. 34 TWP. 28S RGE. 11W

WELL PLAT

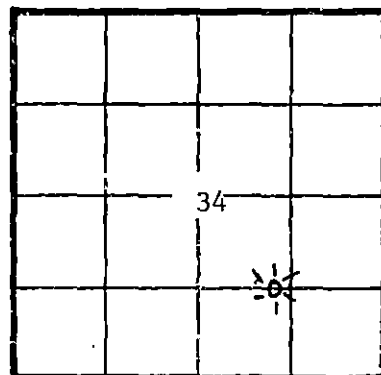

KCC
KGS
(Office Use)

PLUGGING NONE
CONTRACTOR
ADDRESS

TOTAL DEPTH 3071' PBDT

SPUD DATE 3/9/82 DATE COMPLETED 3/13/82

ELEV: GR 1826 DF 1832 KB 1834

DRILLED WITH (CABLE) (ROTARY) (AIR) TOOLS

Amount of surface pipe set and cemented 8 5/8" @ 406' DV Tool Used?

AFFIDAVIT

STATE OF KANSAS, COUNTY OF SEDGWICK SS, I,

Phyllis Buchanan OF LAWFUL AGE, BEING FIRST DULY SWORN UPON HIS OATH,

DEPOSES THAT HE IS Agent (FOR) Associated Petroleum Consultants, Inc.

OPERATOR OF THE Dudrey LEASE, AND IS DULY AUTHORIZED TO MAKE

THIS AFFIDAVIT FOR AND ON THE BEHALF OF SAID OPERATOR, THAT WELL NO. #1 ON


SAID LEASE HAS BEEN COMPLETED AS OF THE 30th DAY OF March, 19 82, AND THAT

ALL INFORMATION ENTERED HEREIN WITH RESPECT TO SAID WELL IS TRUE AND CORRECT.

FURTHER AFFIANT SAITH NOT.

(S) Phyllis Buchanan
PHYLLIS BUCHANAN

SUBSCRIBED AND SWORN BEFORE ME THIS 9th DAY OF April, 19 82.

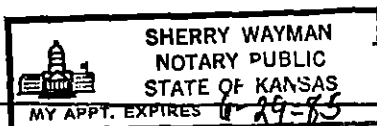

Sherry Wayman
NOTARY PUBLIC
SHERRY WAYMAN

MY COMMISSION EXPIRES:

\*\*The person who can be reached by phone regarding any questions concerning this information. Within 45 days of completion, a witnessed initial test by the Commission is required if the well produces more than 25 BOPD or is located in a Basic Order Pool.

RECEIVED
STATE CORPORATION COMMISSION
6 1982
05-28-82
CONSERVATION DIVISION
Wichita Kansas

**SIDE TWO**

**WELL LOG**

SHOW GEOLOGICAL MARKERS, LOGS RUN, OR OTHER DESCRIPTIVE INFORMATION.

Show all important zones of porosity and contents thereof; cored intervals, and all drill-stem tests, including depth interval tested, cushion used, time tool open, flowing and shut-in pressures, and recoveries.

FORMATION DESCRIPTION, CONTENTS, ETC.	TOP	BOTTOM	NAME	DEPTH
DST #1 2590 - 2674 op30 si60 op30 si60 Very strong blow with gas-to-surface in 3 minutes.			Indian Cave	2625 (- 791)
			Wabaunsee	2677 (- 843)
			Tarkio	2875 (-1041)
			Burlingame	2977 (-1143)
			Howard	3054 (-1220)
			RTD	3070 (-1236)
			LTD	3071 (-1237)
<u>Initial Flow Period</u>				
Time      PSI      Size of Orifice      Gauge				
7          18          2"                      3.12 MCF				
17         36          2"                      4.83 MCF				
27         42          2"                      5.402 MCF				
Started blowing mud and water 11 minutes into initial flow period.				
<u>Final Flow Period</u>				
Time      PSI      Size of Orifice      Gauge				
10         49          2"                      6.066 MCF				
20         49          2"                      6.066 MCF				
30         49          2"                      6.066 MCF				
Recovery: 65' gas cut watery mud				
IHH          1245 psi          FHH      1235 psi				
IFP          324-620 psi      FFP      699-689 psi				
ICIP          917 psi          FCIP      917 psi				
BHT          102° F				

**Report of all strings set — surface, intermediate, production, etc. CASING RECORD (New) or (Used)**

Purpose of string	Size hole drilled	Size casing set (in O.D.)	Weight lbs/ft.	Setting depth	Type cement	Sacks	Type and percent additives
Surface	12½"	8 5/8"	23#	406'	Common	250	3% CaCl 2% gel
					light weight	250	3% CaCl
Production		4½"	10.5#	2733'	RFC	75	

**LINER RECORD**

**PERFORATION RECORD**

Top, ft.	Bottom, ft.	Sacks cement	Shots per ft.	Size & type	Depth interval
NONE			4	Jet	2640 - 50

**TUBING RECORD**

Size	Setting depth	Packer set at
2 3/8"	2614'	NONE

**ACID, FRACTURE, SHOT, CEMENT SQUEEZE RECORD**

Amount and kind of material used	Depth interval treated
500 gal of 10% MCA + 30 barrels Indian Cave Saltwater	2620 - 24

Date of first production March 31, 1982	Producing method (flowing, pumping, gas lift, etc.) Open Flow	<del>OPEN FLOW</del>
RATE OF PRODUCTION PER 24 HOURS	Oil      0      bbls.	Gas      3568      MCF
	Water      0      %	Gas-oil ratio      -----      CFPB
Disposition of gas (vented, used on lease or sold) sold	Perforations      2640 - 50	