

STATE OF KANSAS
KANSAS CORPORATION COMMISSION
CONSERVATION DIVISION
130 South Market - Room 2078
Wichita, Kansas 67202

RECEIVED
KANSAS CORPORATION COMMISSION
8-13-2002
AUG 13 2002
FORM CP 13792

WELL PLUGGING APPLICATION FORM
(PLEASE TYPE FORM and File ONE Copy)

CONSERVATION DIVISION
WICHITA, KS

API # 15-189-10059-0000 (Identifier number of this well). This must be listed for wells drilled since 1967; if no API# was issued, indicate spud or completion date. 4/03

WELL OPERATOR Exxon Mobil Corporation KCC LICENSE # 5208
(owner/company name) (operator's)

ADDRESS PO Box 4358 CITY Houston

STATE TX ZIP CODE 77210 CONTACT PHONE # () 713-431-1828

LEASE Heger "C" WELL# 1 SEC. 36 T. 33 R. 36 (East/West)

C - NE - SW SPOT LOCATION/OQQQ COUNTY Stevens

1971 FEET (in exact footage) FROM (S)/N (circle one) LINE OF SECTION (NOT Lease Line)

1983 FEET (in exact footage) FROM E/(W) (circle one) LINE OF SECTION (NOT Lease Line)

Check One: OIL WELL GAS WELL D&A SWD/ENHR WELL DOCKET# _____

CONDUCTOR CASING SIZE _____ SET AT _____ CEMENTED WITH _____ SACKS

SURFACE CASING SIZE 9 5/8 SET AT 767' CEMENTED WITH 400 SACKS

PRODUCTION CASING SIZE 5 1/2 SET AT 6430' CEMENTED WITH 570 SACKS

LIST (ALL) PERFORATIONS and BRIDGEPLUG SETS: Please see attached

ELEVATION 3024' T.D. 6446' PBDT 2932' ANHYDRITE DEPTH _____
(G.L./K.B.) (Stone Corral Formation)

CONDITION OF WELL: GOOD POOR CASING LEAK JUNK IN HOLE

PROPOSED METHOD OF PLUGGING Please see attached / Per the rules and regulations of the KCC

(If additional space is needed attach separate page)

IS WELL LOG ATTACHED TO THIS APPLICATION AS REQUIRED? NO IS ACO-1 FILED? Yes

If not explain why? Logs can not be located

PLUGGING OF THIS WELL WILL BE DONE IN ACCORDANCE WITH K.S.A. 55-101 et. seq. AND THE RULES AND REGULATIONS OF THE STATE CORPORATION COMMISSION.

LIST NAME OF COMPANY REPRESENTATIVE AUTHORIZED TO BE IN CHARGE OF PLUGGING OPERATIONS:

Richard Lewis PHONE# () 316-544-5534

ADDRESS 200 W. 4th Street City/State Hugoton, KS 67951

PLUGGING CONTRACTOR Sargent & Horton KCC LICENSE # 31151
(company name) (contractor's) 1/03

ADDRESS Rt. 1, Box 49BA, Tyrone, KS 73951 PHONE # () 580-854-6515

PROPOSED DATE AND HOUR OF PLUGGING (If Known?) ASAP

PAYMENT OF THE PLUGGING FEE (K.A.R. 82-3-118) WILL BE GUARANTEED BY OPERATOR OR AGENT

DATE: 7-31-02 AUTHORIZED OPERATOR/AGENT: Colleen Reda
(signature)

AUG 13 2002

CONSERVATION DIVISION
WICHITA, KS

API# 15-189-10059


PRELIMINARY B&A SKETCH-PLUGS WILL CHANGE PER THE DIRECTIONS OF THE KCC DISTRICT REPRESENTATIVE

COMPANY: Exxon Mobil Oil Corporation
WELL NAME: Heger "C"
WELL #: 1
API#: 15-189-10059
COUNTY: Stevens

SURFACE CASING			
OD	WT / FT	GRADE	SET AT
9 5/8"	36	J-55	767'
PRODUCTION CASING			
OD	WT / FT	GRADE	SET AT
5 1/2"	17	J-55	6430'
TUBING			
OD	WT / FT	GRADE	SET AT
NONE			

CAPACITIES (BBL/FT)	
2 3/8" TBG	0.00387
5 1/2" CSG	0.0232
2 3/8" x 5 1/2"	0.0178

BEFORE

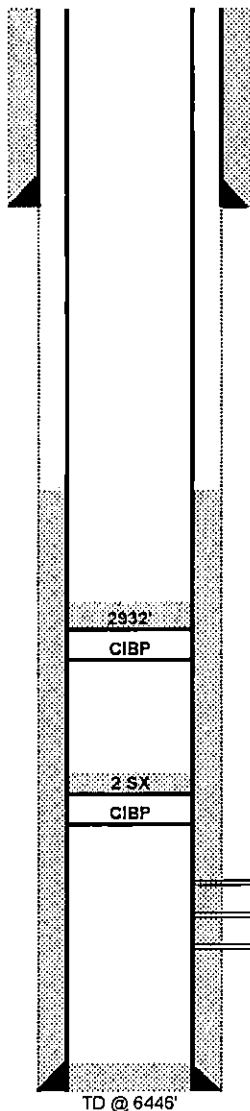

TOC @ 20' ; GRAVEL FROM 0' - 20'

9 5/8" OD SURFACE CSG SET @ 767'

CUT & CAP WELL @ 3' BELOW GROUND LEVEL.
PLUG # (1) 3' - 817'

CUT 5 1/2" CSG @ 817'

****PLUGS WILL NEED TO BE SET ACROSS THE FOLLOWING FORMATIONS:
CHEYENNE, DAKOTA, ARBUCKLE,
ANY SALT ZONES, ANY FRESH WATER ZONES**

TOC @ 2291'

CIBP SET @ 2952' W/ 2 SX CMT ON TOP

CIBP SET @ 5985' W/ 20' CMT ON TOP

6104' SQ'D W/ 245 SX


6112' - 20'

6134' - 44'

TD @ 6446'

5 1/2" OD PRODUCTION CSG SET @ 6430'

AFTER

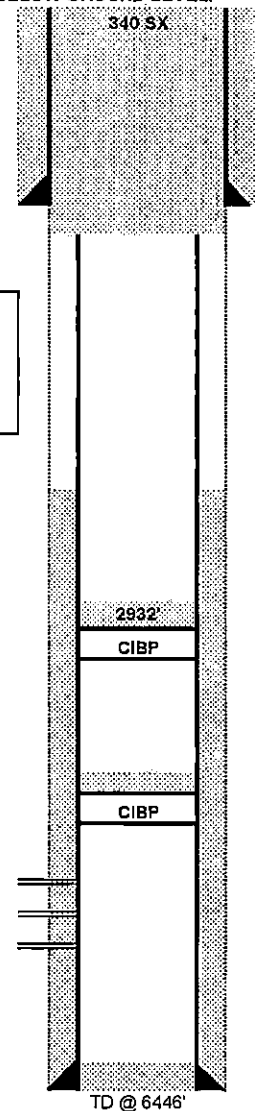

340 SX

2932

CIBP

2

CIBP

TD @ 6446'

AUG 13 2002

PROPOSED PLUGGING PROCEDURE FOR EXXON MOBIL CORPORATION

WELL: HEGER 'C' # 1
FIELD: HUGOTON
COUNTY: STEVENS

CONSERVATION DIVISION
WICHITA, KS



**THIS IS A CATEGORY III WORKOVER.
BOPE SPECIFICATIONS: CLASS IV 300**

**NOTE: PERFORM ALL WELL WORK OPERATIONS IN ACCORDANCE WITH THE
HPO WORKOVER OPERATIONS MANUAL.**

NOTE: USE CLASS 'H', 16.4 PPG, 1.06 YIELD CEMENT FOR ALL PLUGS.

NOTE: PUMP 9.5 PPG MUD LADEN FLUID BETWEEN CEMENT PLUGS.

**NOTE: NOTIFY KCC DISTRICT OFFICE IN DODGE CITY, KS PRIOR TO
COMMENCEMENT OF WORK & WITHIN SUFFICIENT TIME TO WITNESS PLUGGING
OPERATIONS.**

**NOTE: ENSURE PLUGGING FORMS HAVE APPROPRIATE INFORMATION NEEDED TO
FILE APPROPRIATE PAPERWORK W/ THE KCC TO CONCLUDE PLUGGING
OPERATIONS.**

**Check pressures on all casing strings daily and document on morning reports. Discuss safe blow
down/well kill procedures with Exxon Mobil Workover Supervisor.**

1. INSPECT JOBSITE FOR POTENTIAL HAZARDS & LOCATION CHARACTERISTICS THAT MAY IMPACT THE PLANNED WELLWORK AND/OR REQUIRE MODIFICATION OF THE PROCEDURE. INITIATE MOC PROCESS IF NEEDED.
2. SET & TEST RIG ANCHORS AS NEEDED.
3. **PLUG WELL AS DIRECTED BY KCC DISTRICT REPRESENTATIVE.** A GENERAL PLAN IS AS FOLLOWS, BUT SHOULD BE REVISED TO ENSURE ALL FORMATIONS (INCLUDING THE CHEYENNE FORMATION, DAKOTA FORMATION, ARBUCKLE FORMATION, ANY SALT FORMATIONS & ANY FRESH & USABLE WATER ZONES) ARE ISOLATED AS PER THE SPECIFICATIONS OF THE KCC.
4. NIPPLE UP ON 5 1/2" CSG. RU JACKS.
5. REMOVE CSG HANGER. RD JACKS.
6. SET BOP'S W/ 5 1/2" PIPE RAMS & TEST.
7. RU WL UNIT W/ CLASS II LUBRICATOR & TEST. CUT 5 1/2" CSG @ 817'. RD WL UNIT.
8. CIRCULATE & CONDITION MUD.
9. RECOVER 5 1/2" CSG.
10. CHANGE BOP RAMS TO 2 3/8" TBG.
11. RIH W/ 2 3/8" TBG WORKSTRING TO 817'.
12. SET 340 SX CEMENT PLUG FROM 3' - 817'.
13. POH W/ WORKSTRING.
14. REMOVE BOP'S.
15. CUT & CAP WELL 3' BELOW GROUND LEVEL.
16. RD/MO.

8/1/02



Kansas Corporation Commission

Bill Graves, Governor John Wine, Chair Cynthia L. Claus, Commissioner Brian J. Moline, Commissioner

NOTICE OF RECEIPT OF WELL PLUGGING APPLICATION (CP-1)

EXXONMOBIL Oil Corp
PO Box 4358
Houston, TX 77210-4358

August 14, 2002

Re: HEGER - C #1
API 15-189-10059-00-00
CNESW 36-33S-36W, 1971 FSL 1983 FWL
STEVENS COUNTY, KANSAS

Dear Operator:

This letter is to notify you that the Conservation Division is in receipt of your plugging proposal, form CP-1, for the above-captioned well.

Your CP-1 has been reviewed by the Conservation Division central office for completeness and to verify license numbers. The plugging proposal will now be forwarded to the district office listed below for review of your proposed method of plugging.

Please contact the district office for approval of your proposed plugging method at least five (5) days before plugging the well, pursuant to K.A.R. 82-3-113 (b). If a workover pit will be used during the plugging of the well it must be permitted. A CDP-1 form must be filed and approved prior to the use of the pit.

The Conservation Division's review of form CP-1, either in the central or district office, does not include an inquiry into well ownership or the filing operator's legal right to plug the well.

This notice in no way constitutes authorization to plug the above-captioned well by persons not having legal rights of ownership or interest in the well. This notice is void after ninety (90) days from the above date.

Sincerely

A handwritten signature in cursive script, appearing to read "David P. Williams".

David P. Williams
Production Supervisor

District: #1
210 E Frontview, Suite A
Dodge City, KS 67801
(316) 225-8888