


STATE OF KANSAS
STATE CORPORATION COMMISSION

WELL PLUGGING RECORD

Give All Information Completely
Make Required Affidavit
Mail or Deliver Report to
Conservation Division
State Corporation Comm.
245 North Water
Wichita, KS 67202

Pratt County, Sec. 18 Twp. 28S Rge. 12W 1/2 W
Location as "NE/CNW 1/4 SW 1/4" or footage from lines
50' S of C SE/4 SE/4 NE/4
Lease Owner Gear Petroleum Company
Lease Name Bailey Well No. 1-A
Office Address 300 Sutton Place, Wichita, Kansas 67202
Character of Well (Completed as Oil, Gas or Dry Hole)

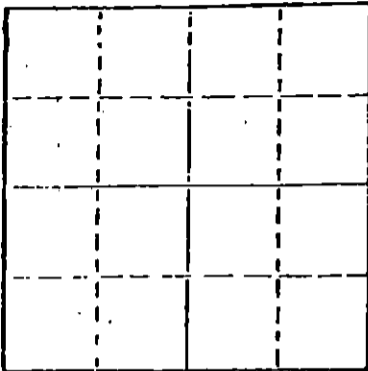

Date Well completed July 13, 1980
Application for plugging filed July 13, 1980
Application for plugging approved July 13, 1980
Plugging commenced July 13, 1980
Plugging completed July 14, 1980
Reason for abandonment of well or producing formation D & A

If a producing well is abandoned, date of last production 19__

Was permission obtained from the Conservation Division or its agents before plugging was commenced? Yes

Name of Conservation Agent who supervised plugging of this well Wm. T. Owen
Producing formation _____ Depth to top _____ Bottom _____ Total Depth of Well 4,650'
Show depth and thickness of all water, oil and gas formations.

OIL, GAS OR WATER RECORDS

CASING RECORD

FORMATION	CONTENT	FROM	TO	SIZE	PUT IN	PULLED OUT
				13 3/8"	209'	-0-
				8 5/8"	992.69'	-0-

Describe in detail the manner in which the well was plugged, indicating where the mud fluid was placed and the method or methods used in introducing it into the hold. If cement or other plugs were used, state the character of same and depth placed, from _____ feet to _____ feet for each plug set.

Bottom Plug @ 435' w/50 sx cement
Second Plug @ 190' w/50 sx cement
Top Plug @ 40' w/2 sx hulls & 25 sx cement
5 sx cement in rathole

RECEIVED
STATE CORPORATION COMMISSION
AUG 12 1980
CONSERVATION DIVISION
Wichita, Kansas

(If additional description is necessary, use BACK of this sheet)

Name of Plugging Contractor Red Tiger Drilling Company
1720 KSB&T Building, Wichita, Kansas 67202

STATE OF Kansas COUNTY OF Sedgwick, ss. contractor
Gloria Fawcett (employee of ~~owner~~ or ~~owner~~ or ~~operator~~)


of the above-described well, being first duly sworn on oath, says: That I have knowledge of the facts, statements, and matters herein contained and the log of the above-described well as filed and that the same are true and correct. So help me God.

(Signature) Gloria Fawcett
1720 KSB&T Building, Wichita, Kansas 67202
(Address)

SUBSCRIBED AND SWORN TO before me this 23rd day of July, 1980.

Joyce A. Hagermann
Notary Public.

My commission expires _____

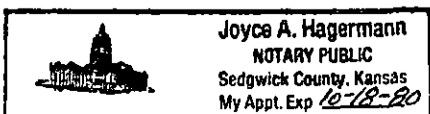

DRILLERS LOG

No. 1-A Bailey

CASING RECORD:
13 3/8" @ 209'
w/225 sx cement
8 5/8" @ 1,000'
w/150 sx cement

COMPANY: Gear Petroleum Company
CONTRACTOR: Red Tiger Drilling Company
COMMENCED: July 2, 1980
COMPLETED: July 14, 1980

DESCRIPTION:
50' S of C SE/4 SE/4 NE/4
Sec. 18-T28S-R12W
Pratt County, Kansas

D & A

TOTAL DEPTH: 4,650'

ELEVATION: 1,853' GL

<u>FORMATION</u>	<u>FROM</u>	<u>TO</u>	<u>REMARKS</u>
Surface Soil	0	215	
	215	1014	No returns
Shale & Lime	1014	1785	
Lime & Shale	1785	2103	
Shale & Lime	2103	2305	
Lime	2305	2490	
Shale & Lime	2490	2655	
Lime & Shale	2655	2860	
Lime	2860	3160	
Lime w/Shale	3160	3360	
Lime	3360	3580	
Lime & Shale	3580	3770	
Lime	3770	4140	
Lime & Conglomerate	4140	4265	
Mississippi Lime	4265	4282	
KWHK	4282	4376	
Viola	4376	4385	
Chert	4385	4442	
Lime	4442	4472½	
Simpson Sand & Shale	4472½	4560	
Lime & Shale	4560	4650	
RTD		4650	

I certify that this is a true and correct copy of the above log to the best of my knowledge.

RED TIGER DRILLING COMPANY

Gloria Fawcett
Gloria Fawcett

RECEIVED
STATE CORPORATION COMMISSION
AUG 12 1980
CONSERVATION DIVISION
Wichita, Kansas

Subscribed and sworn to before me this 23rd day of July, 1980.

Joyce A. Hagermann
Notary Public

