


STATE OF KANSAS
STATE CORPORATION COMMISSION

Form CP-4

Give All Information Completely
Make Required Affidavit
Mail or Deliver Report to
Conservation Division
State Corporation Commission

WELL PLUGGING RECORD

P. O. Box 17027
Wichita, Kansas 67217
NORTH

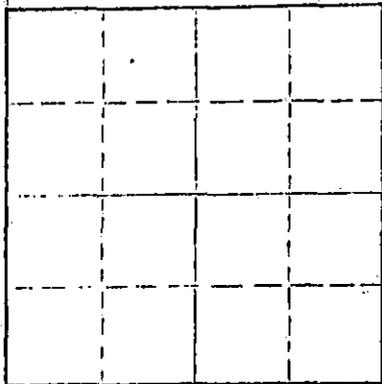

Locate well correctly on above
Section Plat

Pratt County, Sec. 13 Twp. 28 Rge. (E) 12 (W)
Location as "NE/CNW&SW" or footage from lines 50' W of C NE NE SW
Lease Owner Wayne L. Kirlman
Lease Name Simmons Well No. 1
Office Address P. O. Box 18148 - Wichita, Kansas
Character of Well (completed as Oil, Gas or Dry Hole) Dry Hole
Date well completed December 21, 1974
Application for plugging filed December 21, 1974
Application for plugging approved 19
Plugging commenced December 21, 1974
Plugging completed December 21, 1974
Reason for abandonment of well or producing formation Dry Hole

If a producing well is abandoned, date of last production 19
Was permission obtained from the Conservation Division or its agents before plugging was commenced? yes

Name of Conservation Agent who supervised plugging of this well G. Russell Biberstein of Attica
Producing formation Depth to top Bottom Total Depth of Well 4164 Feet
Show depth and thickness of all water, oil and gas formations.

OIL, GAS OR WATER RECORDS

CASING RECORD

FORMATION	CONTENT	FROM	TO	SIZE	PUT IN	PULLED OUT
	Surface Casing	0	282'	8 5/8"	282'	none

Describe in detail the manner in which the well was plugged, indicating where the mud fluid was placed and the method or methods used in introducing it into the hole. If cement or other plugs were used, state the character of same and depth placed, from feet to feet for each plug set.

Heavy mud from Total Depth to 250 feet,
35 sacks cement plug - mud to 40',
plug, bridged and 10 sack cement to
base of cellar - 2 sacks in rats hole.
Job completed at 3:00 AM

RECEIVED
STATE CORPORATION COMMISSION

RECEIVED
STATE CORPORATION COMMISSION

JAN 7 1975 01-07-75

JAN 15 1975 01-05-75

CONSERVATION DIVISION
Wichita, Kansas

CONSERVATION DIVISION
Wichita, Kansas

(If additional description is necessary, use BACK of this sheet)
Name of Plugging Contractor Search Drilling Company
Address P. O. Box 18148 - Wichita, Kansas 67218

STATE OF KANSAS COUNTY OF SEDGWICK, ss.

V. S. Fabian - Search Drilling Co. (employee of owner) or (owner or operator) of the above-described well, being first duly sworn on oath, says: That I have knowledge of the facts, statements, and matters herein contained and the log of the above-described well as filed and that the same are true and correct. So help me God.

(Signature) V. S. Fabian
P. O. Box 18148 - Wichita, Kansas
(Address)

Subscribed and sworn to before me this 27th day of December, 1974

Commission expires February 19, 1977

Maxine Dressen
Notary Public.



