

STATE OF KANSAS
STATE CORPORATION COMMISSION


Form CP-4

WELL PLUGGING RECORD

Give All Information Completely
Make Required Affidavit
Mail or Deliver Report to:
Conservation Division
State Corporation Commission
212 No. Market
Wichita, Kansas

Pratt ~~XXXXXXX~~ County. Sec. 8 Twp. 28S Rge. 12W (E) (W)

Location as "NE/CNW/SW" or footage from lines C SW NE
Lease Owner Leben Drilling, Inc.
Lease Name Becker Well No. 1
Office Address Box 486, Great Bend, Kansas 67530
Character of Well (completed as Oil, Gas or Dry Hole) Dry Hole
Date well completed 12-13-66 19
Application for plugging filed 12-13-66 19
Application for plugging approved 12-13-66 19
Plugging commenced 12-13-66 19
Plugging completed 12-13-66 19
Reason for abandonment of well or producing formation Dry Hole

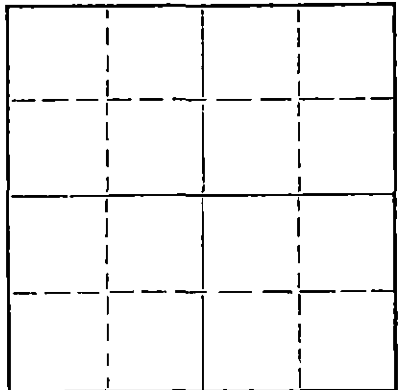

Locate well correctly on above Section Plat

If a producing well is abandoned, date of last production 19
Was permission obtained from the Conservation Division or its agents before plugging was commenced? yes

Name of Conservation Agent who supervised plugging of this well Gilbert Toman, Holyrood for Archie Elving,
Producing formation _____ Depth to top _____ Bottom _____ Total Depth of Well 4595 Feet Pratt
Show depth and thickness of all water, oil and gas formations.

OIL, GAS OR WATER RECORDS

CASING RECORD

FORMATION	CONTENT	FROM	TO	SIZE	PUT IN	PULLED OUT
				8 5/8"	360;	none

Describe in detail the manner in which the well was plugged, indicating where the mud fluid was placed and the method or methods used in introducing it into the hole. If cement or other plugs were used, state the character of same and depth placed, from _____ feet to _____ feet for each plug set.

Mud to 300' with 1/4 sk. hulls and Plug with 25 sacks cement
Mud to 40' with 1/2 sk. hulls and Plug with 10 sacks cement
2 sacks cement put in rathole

DEC 19 1966
12-19-66
CONSERVATION DIVISION
Wichita, Kansas

(If additional description is necessary, use BACK of this sheet)

Name of Plugging Contractor Leben Drilling, Inc.
Address Box 486, Great Bend, Kansas 67530

STATE OF KANSAS, COUNTY OF Barton, ss.

Leslie Kite (employee of owner) or (owner or operator) of the above-described well, being first duly sworn on oath, says: That I have knowledge of the facts, statements, and matters herein contained and the log of the above-described well as filed and that the same are true and correct. So help me God.

(Signature) Leslie Kite

P. O. Box 486, Great Bend, Kansas 67530
(Address)

SUBSCRIBED AND SWORN to before me this 16th day of December, 19 66

My commission expires April 1, 1967

Ulanda Nichols
Ulanda Nichols
Notary Public.

DRILLER'S LOG

COMPANY: Leben Drilling, Inc.
 CONTRACTOR: LEBEN DRILLING, INC.
 FARM: BECKER #1
 LOCATION: C SW NE SEC. 8-28S-12W
 PRATT COUNTY, KANSAS
 COMMENCED: 12-2-66
 COMPLETED: 12-13-66

0	195	Clay, Sand, Gravel
195	360	Redbed
360	840	Shale
840	1685	Shale, Shells
1685	1745	Shale, Lime
1745	2465	Lime, Shale
2465	2900	Shale, Lime
2900	3535	Lime, Shale
3535	4198	Lime
4198	4290	Mississippi Lime
4290	4323	Lime
4323	4365	Kinderhook
4365	4370	Chert
4370	4454	Viola
4454	4499	Simpson
4499	4508	Simpson Sand
4508	4539	Simpson
4539	4569	Lime, Shale
4569	4595	Arbuckle
	<u>4595</u>	<u>RTD - D. & A.</u>

RECEIVED
 STATE CORPORATION COMMISSION
 DEC 19 1966
 CONSERVATION DIVISION

8 5/8" used surface casing set @ 360' cemented with 350 sacks of Common cement with 2% cc

I, Leslie Kite, do hereby certify that the above and foregoing is a true and correct copy of the log of the Becker #1 well, located C SW NE of Section 8, Township 28 South, Range 12 West, Pratt County, Kansas, as reflected by the records of Leben Drilling, Inc.

Leslie Kite
 Leslie Kite

STATE OF KANSAS)
) SS
 COUNTY OF BARTON)

Subscribed and sworn to and before me, a Notary Public, in and for Barton County, Kansas, this 16th day of December, 1966.

Ulanda Nichols
 Ulanda Nichols

My Commission Expires:
 April 1, 1967