

WELL PLUGGING RECORD


FORMATION PLUGGING RECORD

STATE OF KANSAS
STATE CORPORATION COMMISSION

Give All Information Completely
Make Required Affidavit
Mail or Deliver Report to:
Conservation Division
State Corporation Commission
800 Bittling Building
Wichita, Kansas

Strike out upper line
when reporting plug-
ging of formations.

NORTH

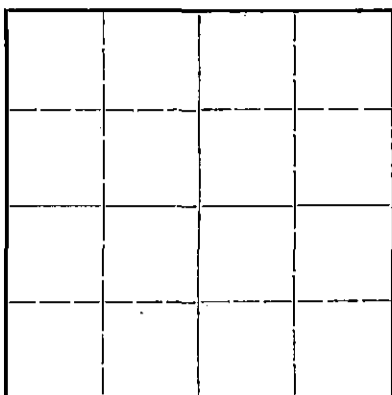

Locate well correctly on above
Section Plat

Pratt County. Sec. 7 Twp. 28 Rge. 12 (W)
 Location as "NE $\frac{1}{4}$ NW $\frac{1}{4}$ SW $\frac{1}{4}$ " or footage from lines 330' from east line 810' from
 Lease Owner Harbar et al north line of the NE $\frac{1}{4}$
 Lease Name Keller Well No. 1
 Office Address 1019 Central Bldg., Wichita, Kansas
 Character of Well (completed as Oil, Gas or Dry Hole) Dry Hole
 Date well completed 3-11-47 19
 Application for plugging filed 3-11-47 Verbal 19
 Application for plugging approved 3-11-47 Verbal 19
 Plugging commenced 3-19-47 19
 Plugging completed 3-19-47 19
 Reason for abandonment of well or producing formation Dry Hole
 If a producing well is abandoned, date of last production 19
 Was permission obtained from the Conservation Division or its agents before plugging was com-
 menced? Yes

Name of Conservation Agent who supervised plugging of this well H. W. Kerr
 Producing formation None Depth to top X Bottom X Total Depth of Well 4545 Feet
 Show depth and thickness of all water, oil and gas formations.

OIL, GAS OR WATER RECORDS

CASING RECORD

Formation	Content	From	To	Size	Put In	Pulled Out
Surface water and sand			40	16" O.D.	40'	None
	Above pipe cemented		W/ 50 sacks cement		circulated	
Water sand & redbeds	Water	40	720'	10 3/4"	720'	None
	Above pipe cemented		W/ 450 sacks cement		circulated	

Describe in detail the manner in which the well was plugged, indicating where the mud fluid was placed and the method or methods used in introducing it into the hold. If cement or other plugs were used, state the character of same and depth placed, from _____ feet to _____ feet for each plug set.

Filled hole with heavy mud from T.D. to 400'
 Set wood plug at 400' and dumped 20 sacks cement
 Filled with heavy mud from top of cement to 15' and filled with 10 sacks cement from top of heavy mud to bottom of cellar

(If additional description is necessary, use BACK of this sheet)

Correspondence regarding this well should be addressed to Harbar Drilling Co., 1019 Central Bldg.
 Address Wichita, Kansas

STATE OF Kansas, COUNTY OF Sedgwick, ss.
 W. A. Grant (employee of owner) or (owner or operator) of the above-described well,
 being first duly sworn on oath, says: That I have knowledge of the facts, statements, and matters herein contained and the log of the above-described well as filed and that the same are true and correct. So help me God.

(Signature)

SUBSCRIBED AND SWORN to before me this 24th day of March 1947

My commission expires Dec. 23, 1950

Mary B. Brann
 Notary Public.

PLUGGING
 FILE SEC 7 T 28 R 12W
 BOOK PAGE 102 LINE 37

03-25-47

HARBAR ET AL.

KELLER #1.

Center SE $\frac{1}{4}$ NE $\frac{1}{4}$ NE $\frac{1}{4}$ Section 7-28-12W, Pratt County, Kansas.

Rigged up 2-10-47
Tearing out rotary tools 3-20-47

Ran 719' of 10-3/4" surface casing set @ 717'
Cemented with 450 sacks of cement

FORMATION	FROM	TO
Surface dirt	0	70
Sand	70	150
Red bed	150	225
Sand	225	455
Shale and sand	455	710
Anhydrite	710	730
Broken lime	730	735
Shale and shells	735	800
Red bed	800	850
Red bed and shale	850	1050
Salt and shale	1050	1130
Shale (broken)	1130	1680
Shale and shells	1680	1780
Lime	1780	1935
Lime (broken)	1935	2035
Shale and Lime	2035	2095
Lime	2095	2270
Shale and Lime	2270	2380
Lime (broken)	2380	2655
Lime and shale	2655	2760
Shale (broken)	2760	2870
Shale and Lime	2870	2940
Lime	2940	2960
Lime and shale	2960	3075
Lime	3075	3405
Shale	3405	3430
Shale and lime	3430	3565
Sand and lime	3565	3595
Lime	3595	3685
Shale and lime	3685	3730
Lime	3730	4065
Shale	4065	4120
Shale and shells	4120	4160
Shale	4160	4180
Lime	4180	4185
Chat	4185	4214
Shale	4214	4217
Shale (broken)	4217	4240
Shale	4240	4255
Chert	4255	4275
Chert and Lime	4275	4365
Shale and lime	4365	4387
Lime	4387	4418
Sand and lime	4418	4445
Shale	4445	4450
Lime and shale	4450	4505
Lime	4505	4547 Total Depth

I, W. A. Grant, certify that, to the best of my knowledge and belief, the above log is true and correct.

Subscribed and sworn to before me this 24th day of March, 1947.

W. A. Grant
STATE CORPORATE
COMM. NO. 2515
MAR 25 1947
Mary B. Brown
Notary Public

My commission expires: *December 23, 1950*

PLUGGING
FILE SEC-7 T-28 R-12W
BOOK PAGE 102 LINE 37