


WELL PLUGGING RECORD

Give All Information Completely  
Make Required Affidavit  
Mail or Deliver Report to  
Conservation Division  
State Corporation Comm.  
245 North Water  
Wichita, KS 67202

Pratt County, Sec. 7 Twp. 28S Rge. 12W E/  
Location as "NE/CNW<sup>1</sup>SW<sup>3</sup>" or footage from lines  
C SE SE

Lease Owner Arrowhead Petroleum, Inc.  
Lease Name DeWeese Well No. #1  
Office Address Box 8287 - Munger Station, Wichita, Ks. 67208  
Character of Well (Completed as Oil, Gas or Dry Hole)  
Dry Hole

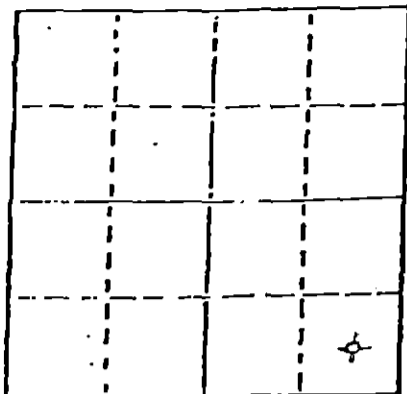

Locate well correctly on above Section Plat

Date Well completed December 24, 1982  
Application for plugging filed December 24, 1982  
Application for plugging approved December 24, 1982  
Plugging commenced December 24, 1982  
Plugging completed December 24, 1982

Reason for abandonment of well or producing formation  
Dry Hole

If a producing well is abandoned, date of last production  
N/A 19

Was permission obtained from the Conservation Division or its agents before plugging was commenced? Yes

Name of Conservation Agent who supervised plugging of this well Maurice V. Leslie

Producing formation Depth to top Bottom Total Depth of Well 4525'

Show depth and thickness of all water, oil and gas formations.

OIL, GAS OR WATER RECORDS

CASING RECORD

FORMATION	CONTENT	FROM	TO	SIZE	PUT IN.	PULLED OUT
Sand				13 3/8"	249'	none
Sand				8 5/8"	1009'	none

Describe in detail the manner in which the well was plugged, indicating where the mud fluid was placed and the method or methods used in introducing it into the hold. If cement or other plugs were used, state the character of same and depth placed, from feet to feet for each plug set.

1280' 50 SX  
1050' 70 SX  
420' 20 SX  
40' 10 SX  
RH 10 SX

50 - 50 POZ 2% gel 3% ccl

(If additional description is necessary, use BACK of this sheet)

Name of Plugging Contractor Sun Oilwell Cementing

STATE OF Kansas COUNTY OF Sedgwick, ss.  
Paul A. Seymour, III (employee of owner) or (owner or operator  
of the above-described well, being first duly sworn on oath, says: That I have knowledge of  
the facts, statements, and matters herein contained and the log of the above-described well  
is true and that the same are true and correct. So help me God.

(Signature) Paul A. Seymour, III  
Paul A. Seymour, III - Box 8287-Munger Station

(Address) Wichita, Ks. 67208

SUBSCRIBED AND SWORN TO before me this 29th day of December, 1982

LaDonna F. Landrum  
Notary Public.  
STATE CORPORATION COMMISSION

commission expires August 18, 1984

