


15-129-20161-00207

WELL PLUGGING RECORD

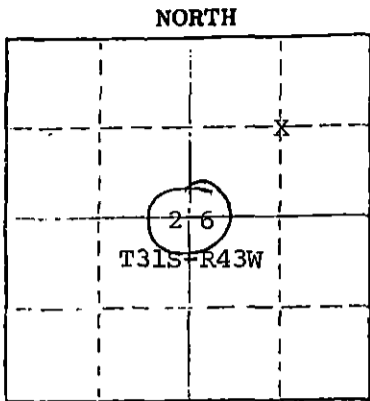

Locate well correctly on above Section Plot

Morton County, Sec. 26 Twp. 31S Rge. (E) 43(W)
 Location as "NE/CNW&SW&W" or footage from lines. C NE/4
 Lease Owner William J. O'Connor
 Lease Name Keefer Well No. #1
 Office Address 1450 United Founders Tower, Okla. City, Okla. 73112
 Character of Well (completed as Oil, Gas or Dry Hole) Gas
 Date well completed September 2, 1974
 Application for plugging filed Verbal Agmt. w/Clarence Thomas, Jr. 9/23/75
 Application for plugging approved Clarence T./Verbal Agmt. Sept. 22, 1975
 Plugging commenced September 22, 1975
 Plugging completed September 24, 1975
 Reason for abandonment of well or producing formation uneconomical

If a producing well is abandoned, date of last production July 1975
 Was permission obtained from the Conservation Division or its agents before plugging was commenced? yes

Name of Conservation Agent who supervised plugging of this well Clarence Thomas Jr.
 Producing formation Waubunsee Depth to top Bottom Total Depth of Well 5235' Feet
 Show depth and thickness of all water, oil and gas formations.

OIL, GAS OR WATER RECORDS

CASING RECORD

| FORMATION | CONTENT | FROM | TO | SIZE | PUT IN | PULLED OUT |
|-----------|---------|-------|-------|--------|--------|------------|
| Waubunsee | Gas | 2782' | 2784' | 4 1/2" | 3258' | 2046.43' |
| | | | | 8 5/8" | 1528' | None |
| | | | | | | |
| | | | | | | |
| | | | | | | |

RECEIVED
 STATE CORPORATION COMMISSION
 SEP 30 1975
 CONSERVATION DIVISION
 Wichita, Kansas

Describe in detail the manner in which the well was plugged, indicating where the mud fluid was placed and the method or methods used in introducing it into the hole. If cement or other plugs were used, state the character of same and depth placed, from feet to feet for each plug set.

Spotted 20 sacks cement, displaced with mud and two sacks hulls to 2500', shot at 2037', spotted 60 sacks cement, displaced with mud and 1 sack hulls, from 1478' - 1578', capped surface with 10 sacks cement 3' - 33', welded on steel plate.

(If additional description is necessary, use BACK of this sheet)

Name of Plugging Contractor Lillard Casing Pulling, Inc.
 Address P.O. Box 962, Woodward, Oklahoma 73801

STATE OF OKLAHOMA COUNTY OF OKLAHOMA, ss.
 Wm. J. O'Connor (owner or operator) of the above-described

well, being first duly sworn on oath, says: That I have knowledge of the facts, statements, and matters herein contained and the log of the above-described well as filed and that the same are true and correct. So help me God.

(Signature) *Wm J O'Connor*
 1450 United Founders Tower-Okla. City, Okla.
 (Address) 73112

Subscribed and Sworn to before me this 29th day of September, 1975

My commission expires 5/28/78
Sandi J. Deaton
 Sandi J. Deaton Notary Public.