


15-129-10159-0000

WELL PLUGGING RECORD

Give All Information Completely
Make Required Affidavit
Mail or Deliver Report to:
Conservation Division
State Corporation Commission
800 Bittling Building
Wichita, Kansas

NORTH

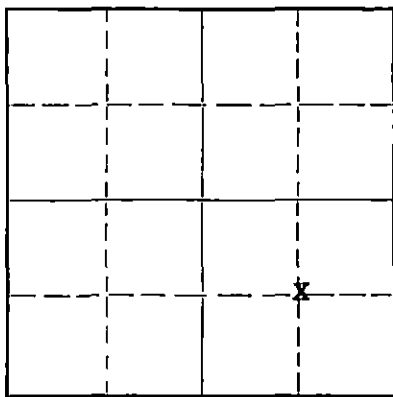

Locate well correctly on above Section Flat

Morton County. Sec. 27 Twp. 31S Rge 43W (W)
Location as "NE/CNW $\frac{1}{4}$ SW $\frac{1}{4}$ " or footage from lines C-SE/ $\frac{1}{4}$
Lease Owner The Superior Oil Company
Lease Name Bogart Well No. 1
Office Address Box 690, Chickasha, Oklahoma
Character of Well (completed as Oil, Gas or Dry Hole) Dry Hole
Date well completed January 31, 19 56
Application for plugging filed February 1, 19 56
Application for plugging approved February 1, 19 56
Plugging commenced March 8, 19 56
Plugging completed March 8, 19 56
Reason for abandonment of well or producing formation Dry

If a producing well is abandoned, date of last production 19
Was permission obtained from the Conservation Division or its agents before plugging was commenced? Yes

Name of Conservation Agent who supervised plugging of this well M. A. Rives
Producing formation None Depth to top Bottom Total Depth of Well 3328 Feet
Show depth and thickness of all water, oil and gas formations.

OIL, GAS OR WATER RECORDS

CASING RECORD

Formation	Content	From	To	Size	Put In	Pulled Out
Wabaunsee	Salt water	2756		10-3/4"	676	None
Elmont	"	3015		7"	3328	1301'
Topeka	"	3166				
LeCompton	"	3308				

Describe in detail the manner in which the well was plugged, indicating where the mud fluid was placed and the method or methods used in introducing it into the hole. If cement or other plugs were used, state the character of same and depth placed, from feet to feet for each plug set.

March 7, 1956: Pulled 1301' 7" Casing.

March 8, 1956: Bailed hole dry to 550 ft. Set Halliburton Plug at 550 ft and 25 sack cement plug dumped on same. Hole filled w/mud to 25 ft. Set Halliburton plug at 25 ft. and dumped 10 sack cement plug on same. Cut off 10-3/4" surface casing 4' below ground level and welded cap on same. Filled cellar with dirt.

RECEIVED
STATE CORPORATION COMMISSION
MAR 10 1956
CONSERVATION DIVISION

(If additional description is necessary, use BACK of this sheet)

Correspondence regarding this well should be addressed to The Superior Oil Company
Address Box 690
Chickasha, Oklahoma

STATE OF Oklahoma, COUNTY OF Grady, ss.

Geo. A. Bannantine (employee of owner) or (owner or operator) of the above-described well, being first duly sworn on oath, says: That I have knowledge of the facts, statements, and matters herein contained and the log of the above-described well as filed and that the same are true and correct. So help me God.

(Signature) Geo. A. Bannantine

Box 690, Chickasha, Oklahoma (Address)

SUBSCRIBED AND SWORN to before me this 9th day of March, 19 56

L. J. Stephens
Notary Public.

7-15-57

My commission expires

PLUGGING
FILE SEC 27 31 R 43W
BOOK PAGE 36 LINE 17

WELL LOG

15-129-10159-0000

Company: The Superior Oil Company

Farm: Bogart #1 C-SE-Section 27-31S-43W, Morton County, Kansas

Total Depth: 3328 Ft.

Contractor: Garvey Drilling Company
Wichita, Kansas

Casing: 10-3/4" At 676 with 400 sacks
7" At 3328 with 400 sacks

<u>Depth</u>		<u>Formation</u>
0	90	Sand & clay
90	120	Gypsum & red beds
120	250	Red beds
250	280	Sand
280	650	Red beds & sand
650	945	Red beds & shells
945	1095	Sand
1095	1304	Red beds & shells
1304	1320	Anhydrite
1320	1450	Red beds and anhydrite streaks
1450	1850	Red beds, shale & sand
1850	2019	Shale & lime
2019	3290	Lime
3290	3328	Shale & lime
3328	T.D.	

State of Kansas

County of Sedgwick

I, Robert F. White of Garvey Drilling Company upon oath state that the above and foregoing is a true and correct copy of the log of the Bogart #1 well.

signed: Robert F. White

Subscribed and sworn to before me this 10th day of January, 1956.

My Commission Expires: August 8, 1959

Signed: Glena M. Omson
Notary Public

COPY

ENGINEERING DIVISION
Wichita, Kansas

COPY

PLUGGING
 FILE SEC. 27-31-S-43W
 BOOK PAGE 36 LINE 17