


Give All Information Completely
Make Required Affidavit
Mail or Deliver Report to:
Conservation Division
State Corporation Commission
800 Bitting Building
Wichita, Kansas

WELL PLUGGING RECORD

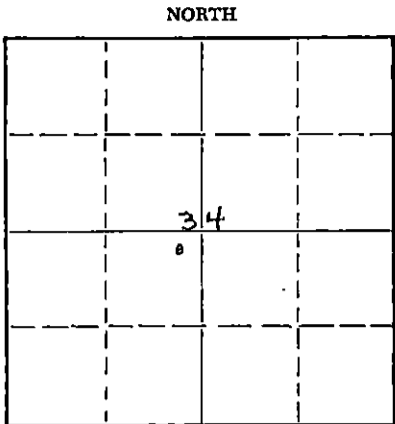

Locate well correctly on above
Section Plat

Norton County, Sec. 34 Twp. 31 Rge. (E) 43 (W)
Location as "NE/CNW/SW" or footage from lines. NE/NE/SW.
Lease Owner Colorado Oil & Gas Corp.
Lease Name Dryer Well No. B-2
Office Address Box 999, Liberal, Kansas
Character of Well (completed as Oil, Gas or Dry Hole) Dry hole
Date well completed February 5, 1954 19
Application for plugging filed May 4, 1955 19
Application for plugging approved Yes 19
Plugging commenced 5-24-55 19
Plugging completed 5-28-55 19
Reason for abandonment of well or producing formation Dry hole

If a producing well is abandoned, date of last production 19
Was permission obtained from the Conservation Division or its agents before plugging was commenced? yes

Name of Conservation Agent who supervised plugging of this well Eldon Petty
Producing formation None Depth to top Bottom Total Depth of Well 5349 Feet
Show depth and thickness of all water, oil and gas formations.

OIL, GAS OR WATER RECORDS

CASING RECORD

FORMATION	CONTENT	FROM	TO	SIZE	PUT IN	PULLED OUT
				8 5/8"		None
				5 1/2"		2455.46'

Describe in detail the manner in which the well was plugged, indicating where the mud fluid was placed and the method or methods used in introducing it into the hole. If cement or other plugs were used, state the character of same and depth placed, from feet to feet for each plug set.

Plugging started 5-24-55 and completed 5-28-55. Measured in to TD. Shot pipe at heavy 2440' and mixed 20 sacks of mud. Pulled pipe out of hole. Plugged well with mud and bailed down hole to 590'. Put in 10' rocks, set permanent rock bridge, and dumped in 20 sacks of cement. Filled hole with heavy mud to 35' of top and dumped 10 sacks of cement for cap on well.

(If additional description is necessary, use BACK of this sheet)
Name of Plugging Contractor FORBES CASING PULLING CO. d/b/a J. O. FORBES
Address P. O. Box 221, Great Bend, Kansas

STATE OF Kansas, COUNTY OF Seward, ss.
A. J. Smith (employee of owner) of the above-described well, being first duly sworn on oath, says: That I have knowledge of the facts, statements, and matters herein contained and the log of the above-described well as filed and that the same are true and correct. So help me God.
(Signature) [Signature]
P.O. Box 999, Liberal, Kansas (Address)

SUBSCRIBED AND SWORN to before me this 17th day of June, 19 55
William B. Claunch
Notary Public.

My commission expires November 1, 1958

PLUGGING
FILE SEC 34 T 31 R 43 W
BOOK PAGE 116 LINE 41

RECORDED
STATE CORPORATION COMMISSION
6-18-55 JUN 13 1955
CONSERVATION DIVISION
Wichita, Kansas

Company: Colorado Oil & Gas Corp.

Sec. 34 T. 31 R. 43W
NE NE SW

Farm: Dreyer

No.: B-2

County: Morton

Kansas

Total Depth: 5349

Comm.: 5-24-55

Comp.: 5-28-55

15-129-00106-0000

Shale & shells	60
Shale, rock & shells	350
Shale & shells	600
Shale & Anhydrite	638
Shale & Shells	925
Sand, shale & shells	1355
Shale & shells	2270
Lime & shale	3339
Total Depth	

Scout Tops:

Wabaunsee	2744
Elmont	2985
Topeka	3150
Lecompton	3283

PLUGGING
WELL SEC 34 T. 31 R. 43W
BOOK PAGE 116 LINE 41

RECEIVED
OIL COMMISSION

MINING DIVISION