


15-129-10010-0000

STATE OF KANSAS
STATE CORPORATION COMMISSION

Give All Information Completely
Make Required Affidavit
Mail or Deliver Report to:
Conservation Division
State Corporation Commission
800 Bittling Building
Wichita, Kansas

WELL PLUGGING RECORD

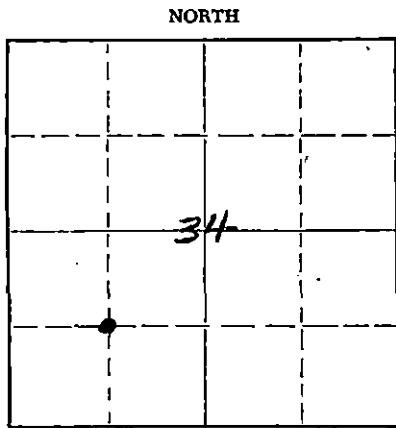

Locate well correctly on above
Section Plat

Morton County, Sec. 34 Twp. 31 Rge. (E) 43(W)
Location as "NE/CNW/SW" or footage from lines C SW 1/4
Lease Owner Colorado Oil & Gas Corp.
Lease Name Dryer Well No. 134
Office Address Box 999, Liberal, Kansas
Character of Well (completed as Oil, Gas or Dry Hole) Dry Hole
Date well completed February 10, 19 55
Application for plugging filed May 4, 19 55
Application for plugging approved Yes 19
Plugging commenced 5-15-55 19
Plugging completed 5-20-55 19
Reason for abandonment of well or producing formation Dry

If a producing well is abandoned, date of last production 19
Was permission obtained from the Conservation Division or its agents before plugging was commenced? Yes

Name of Conservation Agent who supervised plugging of this well M.A. Rives
Producing formation None Depth to top Bottom Total Depth of Well 3337 Feet
Show depth and thickness of all water, oil and gas formations.

OIL, GAS OR WATER RECORDS

CASING RECORD

FORMATION	CONTENT	FROM	TO	SIZE	PUT IN	PULLED OUT
				8 5/8"		None
				5 1/2"		2100.19'

Describe in detail the manner in which the well was plugged, indicating where the mud fluid was placed and the method or methods used in introducing it into the hole. If cement or other plugs were used, state the character of same and depth placed, from feet to feet for each plug set.

Plugging started 5-15-55 and completed 5-20-55.

Measured in to TD 5 1/2"

Shot casing off at 2085' and pulled casing out of hole. Bailed down to 600' and put in 10' rocks. Set permanent rock bridge and dumped in 20 sacks of cement.

Filled hole with heavy mud to 35' of top and dumped 10 sacks of cement for cap on well.

(If additional description is necessary, use BACK of this sheet)

Name of Plugging Contractor FORBES CASING PULLING CO., d/b/a J. O. FORBES
Address P. O. BOX 221, Great Bend, Kansas

STATE OF Kansas, COUNTY OF Seward, ss.
A. J. Smith

(employee of owner) or (owner or operator) of the above-described well, being first duly sworn on oath, says: That I have knowledge of the facts, statements, and matters herein contained and the log of the above-described well as filed and that the same are true and correct. So help me God.

(Signature) [Signature]

P.O. Box 999, Liberal, Kansas
(Address)

Subscribed and sworn to before me this 17th day of June, 19 55

My commission expires November 1, 1958

William B. Claunch
Notary Public.

PLUGGING
FILE SEC 34 T 31 R 43W
MARK RECEIVED 11/1/58

RECEIVED
STATE CORPORATION COMMISSION
6-18-55 JUN 18 1955
CONSERVATION DIVISION
Wichita, Kansas

15-129-10040-0000

WELL LOG

Company: Colorado Oil & Gas Corp.

Sec.: 34 T.: 31 R.: 43W

Farm: Dreyer

No.: #1-34

C SW/4

County: Morton

Kansas

Total Depth: 3340'

Comm.: 1-6-54

Comp.: 1-15-55

Contractor: Holm Drlg. Co.

Issued: 3-12-55

8 5/8" CASING: 629'
5 1/2" 3334'

Elevation: 3597' RB

Production: Dry

Figures Indicate Bottom of Formations

sand & shale	85
Shale & shells	510
Shale & shells	2210
Shale & lime	3075
Lime	3232
Lime & shale	3340
Total Depth	

Tops:	
Wabaunsee	2774
Elmont	3017
Topeka	3176
Lecompton	3312

PLUGGING
 FILE SEC 34 T 31 R 43W
 BOOK PAGE 116 LINE 42

RECEIVED
STATE CORPORATION COMMISSION

JUN 18 1955

CONSERVATION DIVISION
Wichita, Kansas