


Give All Information Completely  
Make Required Affidavit  
Mail or Deliver Report to:  
Conservation Division  
State Corporation Commission  
P. O. Box 17027  
Wichita, Kansas 67217  
NORTH

WELL PLUGGING RECORD

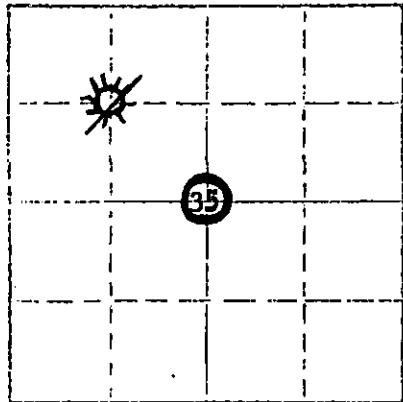

Locate well correctly on above Section Plat

Morton County, Sec. 35 Twp. 31 S Rge. 43 ~~(W)~~ (W)  
Location as "NE/CNW/SEW" or footage from Lines Center NW/4  
Lease Owner Colorado Oil Company  
Lease Name Skinner Well No. 1-35  
Office Address 415 W. 8th St. Suite 300, Amarillo, Texas 79101  
Character of Well (completed as Oil, Gas or Dry Hole) Gas  
Date well completed 12/18 1974  
Application for plugging filed 10/11 1974  
Application for plugging approved 10/11 1974  
Plugging commenced 10/11 1974  
Plugging completed 10/12 1974  
Reason for abandonment of well or producing formation Casing Collapsed

If a producing well is abandoned, date of last production 8/14 1974  
Was permission obtained from the Conservation Division or its agents before plugging was commenced? Yes

Name of Conservation Agent who supervised plugging of this well Mr. Clarence Thomas  
Producing formation Topeka Depth to top 3167 Bottom 3181 Total Depth of Well 3397 Feet  
Show depth and thickness of all water, oil and gas formations.

OIL, GAS OR WATER RECORDS

CASING RECORD

FORMATION	CONTENT	FROM	TO	SIZE	PUT IN	PULLED OUT
Wabaunsee	Salt water	2753	3014	8-5/8	635	None
Elmont	Salt water	3014	3167	5-1/2	3340	None
Topeka	Gas	3167	3304			
Lecompton	Salt water	3304	3397			

Describe in detail the manner in which the well was plugged, indicating where the mud fluid was placed and the method or methods used in introducing it into the hole. If cement or other plugs were used, state the character of same and depth placed, from \_\_\_\_\_ feet to \_\_\_\_\_ feet for each plug set.

Ran 2-3/8" tubing & spotted 25 sx cmt from 3140 to 2920, 35 sx cement from 600' to 300' & 15 sx cmt from 30' to 0'.

RECEIVED  
STATE CORPORATION COMMISSION  
OCT 17 1974  
CONSERVATION DIVISION  
Wichita, Kansas

(If additional description is necessary, use BACK of this sheet)

Name of Plugging Contractor Halliburton Services  
Address Liberal, Kansas

STATE OF TEXAS COUNTY OF POTTER, ss.

\_\_\_\_\_, (employee of owner) or \_\_\_\_\_ of the above-described well, being first duly sworn on oath, says: That I have knowledge of the facts, statements, and matters herein contained and the log of the above-described well as filed and that the same are true and correct. So help me God.

(Signature) W. E. Rawlings  
415 W. 8th St., Suite 300, Amarillo, Texas 79101  
(Address)

SUBSCRIBED AND SWORN to before me this 15th day of October, 1974

Patricia Mann  
Notary Public.