


15-129-00035-0000
WELL PLUGGING RECORD

Give All Information Completely
Make Required Affidavit
Mail or Deliver Report to:
Conservation Division
State Corporation Commission
212 No. Market
Wichita, Kansas

Morton County, Sec. 23 Twp. 31 Rge. (E) 42 (W)

Location as "NE/CNW/SW" or footage from lines C NE/4
Lease Owner Colorado Oil Company
Lease Name Hayward Well No. 1-23
Office Address 915 Union National Bldg., Wichita, Kansas 67202
Character of Well (completed as Oil, Gas or Dry Hole) Gas
Date well completed April 11 19 57
Application for plugging filed May 6 19 71
Application for plugging approved May 7 19 71
Plugging commenced June 7 19 71
Plugging completed June 9 19 71
Reason for abandonment of well or producing formation Depleted

NORTH

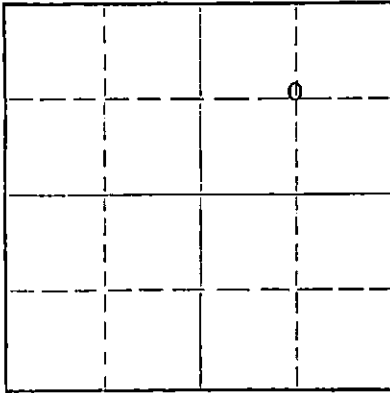

Locate well correctly on above Section Plat

If a producing well is abandoned, date of last production December 31 19 70
Was permission obtained from the Conservation Division or its agents before plugging was commenced? Yes

Name of Conservation Agent who supervised plugging of this well E. Eves
Producing formation Wabaunsee & Morrow Depth to top 2850 Bottom 5228 Total Depth of Well 5335 Feet
Show depth and thickness of all water, oil and gas formations.

OIL, GAS OR WATER RECORDS

CASING RECORD

FORMATION	CONTENT	FROM	TO	SIZE	PUT IN	PULLED OUT
				8-5/8"	1509	None
				5-1/2"	5318	2317

Describe in detail the manner in which the well was plugged, indicating where the mud fluid was placed and the method or methods used in introducing it into the hole. If cement or other plugs were used, state the character of same and depth placed, from _____ feet to _____ feet for each plug set.

Mix 1 sack hulls & 15 sacks cement to plug perfs @ 5100'

Mix 1 sack hulls & 15 sacks cement to plug perfs @ 2886'

Stop top plug @ 2619'

Pulled 2317' 5-1/2" casing.

Put 15 sacks cement @ 45' to 0'.

RECEIVED
STATE CORPORATION COMMISSION
JUN 29 1971
CONSERVATION DIVISION
Wichita, Kansas

(If additional description is necessary, use BACK of this sheet)

Name of Plugging Contractor Sargent's Casing Pulling Service
Address P. O. Box 506, Liberal, Kansas 67901

STATE OF Kansas, COUNTY OF Swdgwick, ss.
Bill K. Henrichs (employee of owner) or (owner or operator) of the above-described well, being first duly sworn on oath, says: That I have knowledge of the facts, statements, and matters herein contained and the log of the above-described well as filed and that the same are true and correct. So help me God.

(Signature) Bill K. Henrichs
915 Union Natl. Bldg., Wichita, Kansas 67202
(Address)

SUBSCRIBED AND SWORN TO before me this 28th day of June, 19 71

My commission expires Feb. 19, 1973

Betty J. McElwain
Betty J. McElwain Notary Public.

CONTRACTOR'S WELL LOG 15-129-00035-0000

COMPANY:	Colorado Oil & Gas Company
CONTRACTOR:	Musgrove Petroleum Corporation
FARM:	HAYWOOD #1
LOCATION:	C NE/4 Sec. 23-31-42 Morton County, Kansas
COMMENCED:	March 1, 1957
COMPLETED:	March 18, 1957

0	40	Shale & sand
40	150	Clay and red rock
150	685	Sand, shale & shells
685	1060	Shale, red bed & shells
1060	1375	Red bed & shells
1375	1510	Red bed & lime shells
1510	1523	Anhydrite
1523	1670	Shale & shells
1670	2403	Red bed & shells
2403	2743	Lime & shale
2743	2845	Shale & shells
2845	3030	Sand, lime & shale
3030	3315	Lime & shale
3315	3696	Lime
3696	4100	Lime & shale
4100	4165	Sand, lime & shale
4165	4345	Lime & shale
4345	4413	Lime
4413	4493	Lime & shale
4493	4575	Lime
4575	5202	Lime & shale
5202	5335	Lime
	5335	Rotary Total Depth

RECEIVED
 MARCH 7 1957
 CONSERVATION DIVISION
 STATE CORPORATION COMMISSION
 Kansas

Set 8-5/8" surface at 1519' with 850 ex cement, 2% calcium chloride & 25% Stratacrete
 Set 5-1/2" oil string at 5328' with 150 ex Pozmix.

STATE OF KANSAS)
 COUNTY OF SEDGWICK) SS

I, EMIL E. BOWERS, do hereby certify that the above and foregoing is a true and correct copy of the log of the HAYWOOD #1, C NE/4, Section 23-31-42W, Morton County, Kansas, as reflected by the files of the Musgrove Petroleum Corporation.

MUSGROVE PETROLEUM CORPORATION

BY Emil E. Bowers
 Secretary Treasurer

Subscribed and sworn to before me, a Notary Public, in and for Sedgwick County, Kansas, this 20th day of March, 1957.

Dean Jaye Hyde
 Notary Public

My commission expires June 16, 1959.