

STATE OF KANSAS
 STATE CORPORATION COMMISSION
 CONSERVATION DIVISION
 P. O. BOX 17027
 WICHITA, KANSAS 67217


15-129-26114-0000

FORM CP-4

WELL PLUGGING RECORD

Morton County, Sec. 23 Twp. 31 Rge. 42 (E) (W) X

Location as "NE/CNWSW" or footage from lines 1250' N. line- 70' E line
 Lease Owner Okmar Oil Co.
 Lease Name Hayward Well No. #1
 Office Address 1130 Vickers KSB&T Bldg. Wichita, Kansas
 Character of Well (completed as Oil, Gas or Dry Hole)
 Date well completed 19
 Application for plugging filed 19
 Application for plugging approved 19
 Plugging commenced 11-22-74 19
 Plugging completed 11-26-74 19
 Reason for abandonment of well or producing formation

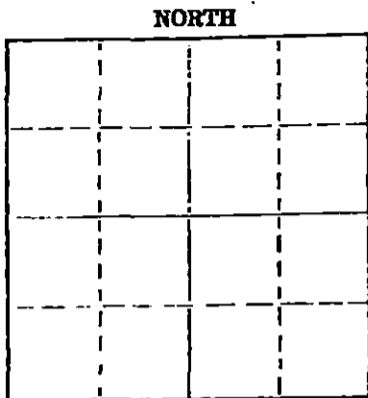

Locate well correctly on above Section Plot

If a producing well is abandoned, date of last production 19
 Was permission obtained from the Conservation Division or its agents before plugging was commenced?

Name of Conservation Agent who supervised plugging of this well Clarence Thomas
 Producing formation Depth to top Bottom Total Depth of Well 3838' Feet
 Show depth and thickness of all water, oil and gas formations.

OIL, GAS OR WATER RECORDS				CASING RECORD		
FORMATION	CONTENT	FROM	TO	SIZE	PUL IN	PULLED OUT
				4 1/2"	3387'	1135.45'
				8 5/8"	744'	

Describe in detail the manner in which the well was plugged, indicating where the mud fluid was placed and the method or methods used in introducing it into the hole. If cement or other plugs were used, state the character of same and depth placed, from feet to feet for each plug set.

Made bottom hole plug back with sand to 2400'. Mixed and ran 4 sacks cement thru dump bailer.
 Plug with 25 sacks gel and 120 sacks cement.

RECEIVED
 STATE CORPORATION COMMISSION
 DEC 3 1974
 CONSERVATION DIVISION
 Wichita, Kansas

Name of Plugging Contractor Southwest Casing Pulling Co. (If additional description is necessary, use BACK of this sheet)
 Address Box 364 Great Bend, Kansas

STATE OF Kansas COUNTY OF Barton ss.
 Southwest Casing Pulling Co. (employee of owner) or (owner or operator) of the above-described well, being first duly sworn on oath, says: That I have knowledge of the facts, statements, and matters herein contained and the log of the above-described well as filed and that the same are true and correct. So help me God.

(Signature) W. C. Spencer, Jr.
 Box 364 Great Bend, Kansas
 (Address)

Subscribed and sworn to before me this 2 day of Dec. 1974



24 October 1976
 Sidney D. Miller
 Notary Public.