

15-129-16152-0000


STATE OF KANSAS  
STATE CORPORATION COMMISSION

WELL PLUGGING RECORD

Give All Information Completely  
Make Required Affidavit  
Mail or Deliver Report to:  
Conservation Division  
State Corporation Commission  
211 No. Broadway  
Wichita, Kansas

Morton County. Sec. 23 Twp. 31 Rge. 42 (X) W (W)  
Location as "NE/CNW/SW" or footage from lines C SE/4  
Lease Owner Petroleum, Inc.  
Lease Name Goddard Gas Unit Well No. 1  
Office Address Route 2, Great Bend, Kansas  
Character of Well (completed as Oil, Gas or Dry Hole) Dry hole  
Date well completed June 23 19 57  
Application for plugging filed July 5 19 57  
Application for plugging approved July 8 19 57  
Plugging commenced July 12 19 57  
Plugging completed July 17 19 57  
Reason for abandonment of well or producing formation No producible zones

NORTH

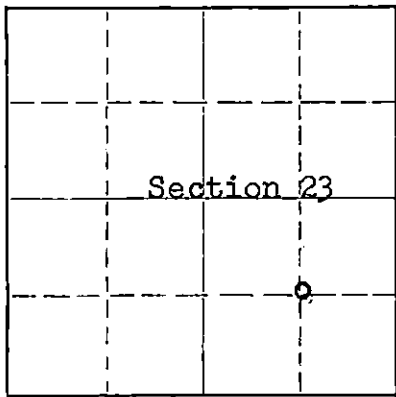

Locate well correctly on above  
Section Plat

If a producing well is abandoned, date of last production None 19  
Was permission obtained from the Conservation Division or its agents before plugging was commenced? Yes

Name of Conservation Agent who supervised plugging of this well M. A. Rives Pratt, Kansas  
Producing formation --- Depth to top --- Bottom --- Total Depth of Well 5403 Feet  
Show depth and thickness of all water, oil and gas formations.

OIL, GAS OR WATER RECORDS

CASING RECORD

FORMATION	CONTENT	FRDM	TO	SIZE	PUT IN	PULLED OUT
				8 5/8"	1512'	None
Morrow Sand	Little gas little water	5069'	5075'	5 1/2"	5360'	4000'

Describe in detail the manner in which the well was plugged, indicating where the mud fluid was placed and the method or methods used in introducing it into the hole. If cement or other plugs were used, state the character of same and depth placed, from \_\_\_\_\_ feet to \_\_\_\_\_ feet for each plug set.

(Plugged back to 5116')

Filled hole with crushed rock from 5116' to 5020' and placed 5 sacks cement on top of rock. Mudded up to 600' and made solid rock bridge on top of mud. Placed 20 sacks cement on top of rock bridge and mudded up to 35'. Made solid rock bridge at 35' and filled hole to base of well cellar with 10 sacks cement.

(If additional description is necessary, use BACK of this sheet)

Name of Plugging Contractor Morgan Well Plugging Service  
Address 102 West 18th Street, Hutchinson, Kansas

STATE OF KANSAS, COUNTY OF Barton, ss.

Don Searle (employee of owner) or (owner) of the above-described well, being first duly sworn on oath, says: That I have knowledge of the facts, statements, and matters herein contained and the log of the above-described well as filed and that the same are true and correct. So help me God.

(Signature) Don Searle

Route 2, Great Bend, Kansas  
(Address)

SUBSCRIBED AND SWORN TO before me this 18th day of July, 19 57

Fred J. Brown  
Notary Public.

My commission expires July 11, 1960

PLUGGING  
FILE SEC 23T 31 R 42W  
BOOK PAGE 25 LINE 24

RECEIVED  
STATE CORPORATION COMMISSION

JUL 19 1957  
7-1957  
CONSERVATION DIVISION  
Wichita, Kansas

# WELL LOG

15-129-1052-6600

COMPANY PETROLEUM, INCORPORATED

SEC. 23 T. 31 S. R. 42 W

FARM GODDARD GAS UNIT NO. 1

LOC. Approx. C/SE/4


TOTAL DEPTH 5493'

COUNTY Morton Co., Kansas

COMM. May 21, 1957

COMP. Jun 9, 1957

CONTRACTOR GARVEY DRILLING COMPANY

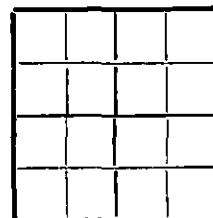

CASING 8 5/8" @ 1512' W/850 sax.  
5 1/2" @ 5360' W/150 sax.

ELEVATION 3465' DF

PRODUCTION Plugged & Abandoned

FIGURES INDICATE BOTTOM OF FORMATIONS

185	Sand rock & shale
400	Shale & shells
1045	Red bed & shells
1120	Gyp
1185	Sand
1340	Gyp, shale & red bed
1500	Shale & shells
1545	Anhydrite
2060	Red bed & sand
2275	Red bed & lime
2645	Red bed & shale
3378	Lime & shale
3462	Lime
3608	Lime & shale
3880	Lime
4921	Lime & shale
5260	Shale
5300	Sand & shale
5311	Sand
5368	Lime & shale
5433	Sand & shale
5493	Shale & lime
5493	T. D.

RECEIVED  
STATE CORPORATION COMMISSION

JUL 19 1957

CONSERVATION DIVISION  
Wichita, Kansas

State of KANSAS }  
County of BARTON } ss:

PLUGGING  
FILE SEC. 23 T. 31 R. 42W  
BOOK PAGE 25 LINE 24

I, Verne A. Morris of Garvey Drilling Co.

upon oath state that the above and foregoing is a true and correct copy of the log of the #1 Goddard Gas Unit well

Verne A. Morris

Subscribed and sworn to before me this 24th day of June 1957

My Commission Expires: July, 11, 1960

[Signature]  
NOTARY PUBLIC