


WELL PLUGGING RECORD

Give All Information Completely
Make Required Affidavit
Mail or Deliver Report to:
Conservation Division
State Corporation Commission
211 No. Broadway
Wichita, Kansas

Seward County, Sec. 6 Twp. 31S Rge. 34W/E (W)
Location as "NE/CNW/SW" or footage from lines _____
Lease Owner Texaco Inc.
Lease Name Anna Day Well No. 1
Office Address 614 Bitting Bldg., Wichita, Kansas.
Character of Well (completed as Oil, Gas or Dry Hole) Dry hole
Date well completed July 11 1962
Application for plugging filed 7-10-62 (Verbal) 19____
Application for plugging approved 7-10-62 (Verbal) 19____
Plugging commenced July 10 1962
Plugging completed July 10 1962
Reason for abandonment of well or producing formation Dry hole

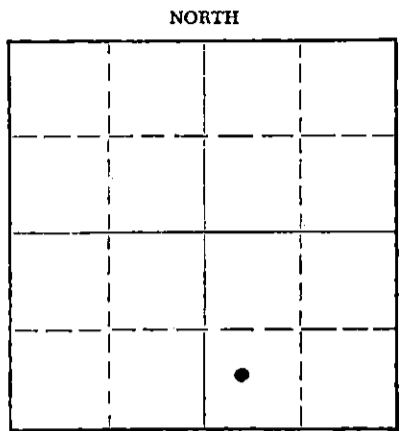

Locate well correctly on above Section Plat

If a producing well is abandoned, date of last production _____ 19____
Was permission obtained from the Conservation Division or its agents before plugging was commenced? Yes

Name of Conservation Agent who supervised plugging of this well Hugh Scott
Producing formation Dry hole Depth to top _____ Bottom _____ Total Depth of Well 5730 Feet
Show depth and thickness of all water, oil and gas formations.

OIL, GAS OR WATER RECORDS

CASING RECORD

FORMATION	CONTENT	FROM	TO	SIZE	PUT IN	PULLED OUT
NONE				8-5/8"	622'	None

Describe in detail the manner in which the well was plugged, indicating where the mud fluid was placed and the method or methods used in introducing it into the hole. If cement or other plugs were used, state the character of same and depth placed, from _____ feet to _____ feet for each plug set.
Hole plugged as follows: Heavy mud 5730-2700, 2700-2450 70 sacks cement, 2450-620 heavy mud, 620-530 30 sacks cement, 530-30 heavy mud, wood plug @ 30', 10 sacks cement to top of surface casing.

RECEIVED
STATE CORPORATION COMMISSION
AUG 13 1962
CONSERVATION DIVISION
Wichita, Kansas

(If additional description is necessary, use BACK of this sheet)
Name of Plugging Contractor Stickle Drilling Company
Address 1100 Bitting Building, Wichita, Kansas

STATE OF Kansas, COUNTY OF Sedgwick, ss.
F. E. Anderson (employee of owner) or (owner or operator) of the above-described well, being first duly sworn on oath, says: That I have knowledge of the facts, statements, and matters herein contained and the log of the above-described well as filed and that the same are true and correct. So help me God.

(Signature) F. E. Anderson, Ass't Dist. Supt.
614 Bitting Bldg., Wichita, Kansas
(Address)

SUBSCRIBED AND SWORN TO before me this 7 day of August, 19 62

My commission expires 6-20-64

A. E. Boyd
Notary Public.



623-10

Texaco, Inc.
Tulsa, Oklahoma

Tulsa, Oklahoma
July 13, 1962

Contractor: Stickle Drilling Company
Date Commenced: June 21, 1962
Date Completed: July 11, 1962

Anna Day No. 1
Ctr. SW SE Sec. 6-318-34W
Seward County, Kansas

15-175-10(28-0000)

DRILLER'S LOG

Depth Figures Indicate Base of Formation:

Surface clay	100
Sand and clay	522
Shale and shells	622
Red bed	1025
Red bed and sand	1680
Shale and anhydrite	1928
Shale	2467
Shale and lime	2579
Lime and shale	2834
Lime	2925
Lime and shale	3286
Shale and lime	3407
Lime and shale	3724
Shale and lime	3824
Lime and shale	4145
Lime	4254
Lime and shale	4379
Lime	4852
Lime and shale	4935
Lime	5103
Shale and lime	5198
Lime	5328
Shale	5337
Lime and shale	6430
Shale	5848
Shale and lime	5580
Lime	5635
Lime and shale	5669
Lime	5730 TD

RECEIVED
STATE CORPORATION COMMISSION
SEP 4 1962
CONSERVATION DIVISION
Wichita, Kansas

I, Fred E. Stickle, hereby certify the above to be a true and complete Driller's Log of Texaco, Inc.'s Anna Day, Well No. 1, Center of SW/4 of SE/4 of Section 6-318-34W., Seward County, Kansas.


FRED E. STICKLE


Edith A. Lammis
Notary Public

My Commission expires March 24, 1964.