


Give All Information Completely  
Make Required Affidavit  
Mail or Deliver Report to:  
Conservation Division  
State Corporation Commission  
211 No. Broadway  
Wichita, Kansas

WELL PLUGGING RECORD

Seward County, Sec. 14 Twp. 31S Rge. -- (E) 34 (W)

Location as "NE/CNW/SW" or footage from lines C SW  
Lease Owner Helmerich & Payne, Inc.  
Lease Name Hyde Well No. 1  
Office Address P.O. Box 558, Garden City, Kansas 67846  
Character of Well (completed as Oil, Gas or Dry Hole) Gas  
Date well completed February 28, 1937  
Application for plugging filed June 7, 1982  
Application for plugging approved June 15, 1982  
Plugging commenced August 30, 1982  
Plugging completed August 31, 1982  
Reason for abandonment of well or producing formation Casing leak

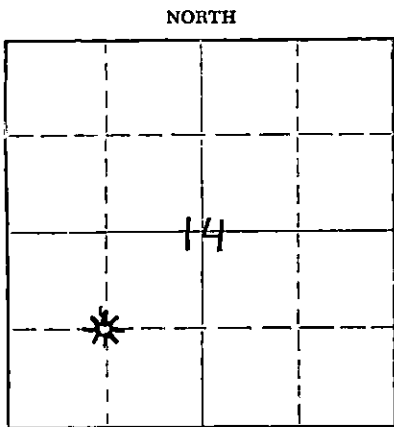

Locate well correctly on above Section Plat

If a producing well is abandoned, date of last production July 1967  
Was permission obtained from the Conservation Division or its agents before plugging was commenced? yes

Name of Conservation Agent who supervised plugging of this well Paul Luthi  
Producing formation Hugoton Series Depth to top 2610 Bottom 2712 Total Depth of Well 2850 Feet  
Show depth and thickness of all water, oil and gas formations.

OIL, GAS OR WATER RECORDS

CASING RECORD

| FORMATION      | CONTENT     | FROM    | TO   | SIZE         | PUT IN | PULLED OUT |
|----------------|-------------|---------|------|--------------|--------|------------|
| Ogallala       | Water       | Surface | 550  |              |        |            |
| Glorietta      | Water       | 1200    | 1350 | 10 3/4"      | 563'   | None       |
| Hugoton Series | Gas & Water | 2610    | 2712 | 5 1/2"       | 2610'  | None       |
|                |             |         |      | 4 1/2" liner | 146'   | None       |

Describe in detail the manner in which the well was plugged, indicating where the mud fluid was placed and the method or methods used in introducing it into the hole. If cement or other plugs were used, state the character of same and depth placed, from \_\_\_\_\_ feet to \_\_\_\_\_ feet for each plug set.

MIRU Post & Mastin Well Service. Rotate out of safety joint on top of Baker AD tension packer. Push packer to top of 4 1/2" liner @ 2540'. Pull 2 jts 2 3/8" tbg to 2476'. Pump 300# sand via 2 3/8" tbg and bridge off and around packer. Pump 15 sks class "H" via tbg and spot in 5 1/2" csg from 2476' to 2360'. Pull 10 jt 2 3/8" tbg to 2166'. Circulate 20 bbl 9ppg, 36 vis mud and spot from 2360' to 1391'. Pull 25 jts 2 3/8" tbg to 1396'. Pump 35 sks class "H" cement via tbg and spot from 1391' to 1121'. Pull 16 jts 2 3/8" tbg to 895'. Circulate hole with 24 bbl of 9 ppg, 36 vis mud via tbg from 1121' to 616'. Pull 9 jts 2 3/8" tbg to 616'. Pump 15 sks class "H" cement via tbg and spot from 616' to 500'. Pull 18 jts 2 3/8" tbg to 58'. This will leave 9 ppg, 36 vis mud from 500' to 58'. Circulate 10 sks of class "H" cement from 58' to surface. Pump 20 sks class "H" cement via 5 1/2" x 10 3/4" annulus. Cement found at surface. Cut 5 1/2" csg head off and top of 10 3/4" surface csg. 4' BGL

Gauge 10 3/4" csg and 5 1/2" csg, cement was down 15' and 9' respectively.  
Mix 4 sks class "H" cement and fill to top. Weld plate onto 10 3/4" surface csg with name of well and date plugged. Use backhoe to fill in cellar. Job complete.

RECEIVED  
STATE CORPORATION COMMISSION  
9-09-82  
SEP 09 1982  
CONSERVATION DIVISION  
Wichita, Kansas

(If additional description is necessary, use BACK of this sheet)

Name of Plugging Contractor Dowell-Division of Dowell Chemical  
Address 204 S. Missouri, Ulysses, Kansas 67880

STATE OF Kansas, COUNTY OF Finney, ss.  
Ken Jelhik (employee of owner) or (~~owner or operator~~) of the above-described well, being first duly sworn on oath, says: That I have knowledge of the facts, statements, and matters herein contained and the log of the above-described well as filed and that the same are true and correct. So help me God.

(Signature) Ken Jelhik  
P.O. Box 558, Garden City, Kansas 67846  
(Address)

SUBSCRIBED AND SWORN to before me this 3rd day of August 1982

Betty J. Purdy  
Notary Public.

My commission expires 8-6-86