


WELL PLUGGING RECORD

Give All Information Completely
Make Required Affidavit
Mail or Deliver Report to:
Conservation Division
State Corporation Commission
212 North Market, Insurance Bldg.
Wichita, Kansas

Clark County. Sec. 6 Twp. 31S Rge. 25W (E) (W)

Location as "NE/CNW/SW" or footage from lines. C SW SW
Lease Owner GULF INTERSTATE
Lease Name HOUSER Well No. 1
Office Address 1125 Brazos Street, Houston, Texas
Character of Well (completed as Oil, Gas or Dry Hole) Dry Hole
Date well completed 11-12-61 19__
Application for plugging filed 11-12-61 19__
Application for plugging approved 11-12-61 19__
Plugging commenced 11-12-61 19__
Plugging completed 11-12-61 19__
Reason for abandonment of well or producing formation Dry

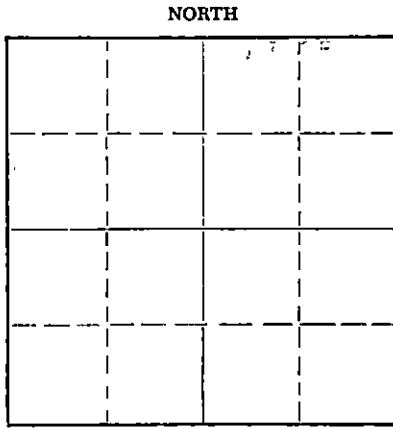

Locate well correctly on above Section Plat

If a producing well is abandoned, date of last production 19__
Was permission obtained from the Conservation Division or its agents before plugging was commenced? Yes

Name of Conservation Agent who supervised plugging of this well W. L. Lackamp
Producing formation _____ Depth to top _____ Bottom _____ Total Depth of Well 6820' Feet
Show depth and thickness of all water, oil and gas formations.

OIL, GAS OR WATER RECORDS

CASING RECORD

FORMATION	CONTENT	FROM	TO	SIZE	PUT IN	PULLED OUT
				8-5/8"	2701'	-0-

Describe in detail the manner in which the well was plugged, indicating where the mud fluid was placed and the method or methods used in introducing it into the hole. If cement or other plugs were used, state the character of same and depth placed, from _____ feet to _____ feet for each plug set.

Plug set @ 6820' w/50 sacks cement
Plug set @ 2700' w/20 sacks cement
Plugged from 35' to surface w/20 sacks cement.

RECEIVED
STATE CORPORATION COMMISSION

JUL 30 1964

7-30-64
CONSERVATION DIVISION
Wichita, Kansas

(If additional description is necessary, use BACK of this sheet)

Name of Plugging Contractor K & E Drilling, Inc.
Address 719 Union Center, Wichita 2, Kansas

STATE OF Kansas, COUNTY OF Sedgwick, ss.
H. L. Wilson

being first duly sworn on oath, says: That I have knowledge of the facts, statements, and matters herein contained and the log of the above-described well as filed and that the same are true and correct. So help me God.

(Signature) H. L. Wilson
H. L. Wilson of K & E Drilling, Inc.
719 Union Center, Wichita, Ks.
(Address)

SUBSCRIBED AND SWORN TO before me this 29th day of November, 19 61

My commission expires August 30, 1965

Julene M. Bannan
Julene M. Bannan
Notary Public.



DRILLER'S WELL LOG

OPERATOR: Gulf Interstate Company
 P. O. Box 1916
 Houston, Texas

WELL NAME: #1 HOUSER
 LOCATION: C SW SW, Sec. 6-31S-25W
 Clark County, Kansas

15-075-00053-0006

CONTRACTOR: **K&E DRILLING, INC.**
 719 UNION CENTER BLDG.
 WICHITA, KANSAS

COMMENCED: 10-9-61

CASING RECORD: 8-5/8" @ 2701' w/1200sx.

COMPLETED: 11-12-61

ELEVATION:

ROTARY TOTAL DEPTH: 6820'

PRODUCTION: Dry

RECEIVED
 STATE CORPORATION COMMISSION

JUL 30 1964

CONSERVATION DIVISION
 Wichita, Kansas

FORMATION RECORD

Depths shown indicate bottom of formations encountered.

Sand	180	Lime	4625
Sand & Shale	385	Lime & Chert	4665
Red Bed	635	Lime	5238
Anhydrite	775	Lime & Shale	5300
Anhy. & Red Bed	1017	Lime	5595
Shale	1175	Lime & Chert	5620
Anhy. & Shale	1324	Lime	5660
Shale	1548	Lime & Chalk	5744
Anhy. & Shale	1880	Lime	5810
Shale	2190	Lime & Chert	5832
Shale & Anhy.	2405	Lime	5986
Anhydrite	2535	Lime & Shale	6008
Lime	2645	Lime	6078
Lime & Shale	2690	Lime & Chert	6119
Lime	2725	Lime	6153
Lime & Chert	2850	Lime & Chert	6228
Lime	3060	Lime	6427
Lime & Pyrite	3145	Chert & Lime	6517
Lime	3370	Lime	6585
Lime & Shale	3540	Lime & Chert	6605
Lime	4450	Lime	6670
Lime & Shale	4558	Lime & Chert	6670
		Lime	6820 RTD

CERTIFICATION

State of KANSAS }
 County of SEDGWICK } ss:

I, H. L. Wilson, of K&E DRILLING, INC., upon oath state that the above and foregoing is a true and correct copy of the Driller's Log of the above named well.

H. L. Wilson

H. L. Wilson

Subscribed and sworn to before me this 27th day of November, 1961.

Julene M. Bannon

Julene M. Bannon

Notary Public.

My Commission expires: August 30, 1965

