


STATE OF KANSAS  
STATE CORPORATION COMMISSION

15-025-20681-0000

WELL PLUGGING RECORD

Give All Information Completely  
Make Required Affidavit  
Mail or Deliver Report to  
Conservation Division  
State Corporation Comm.  
245 North Water  
Wichita, KS 67202

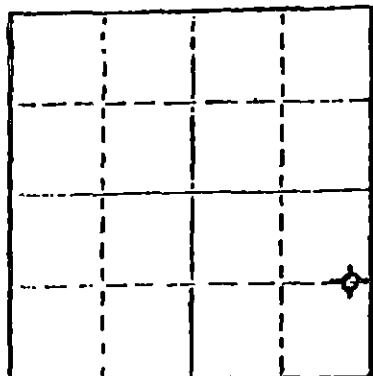

Locate well correctly on above Section Plot

Clark County, Sec. 6 Twp. 31S Rge. 25 N/W  
Location as "NE/CNW $\frac{1}{4}$ SW $\frac{1}{4}$ " or footage from lines \_\_\_\_\_  
E $\frac{1}{2}$  E $\frac{1}{2}$  SE $\frac{1}{4}$   
Lease Owner Rine Drilling Company/Banks Oil Company  
Lease Name Houser Well No. 1  
Office Address 300 W. Douglas, Suite 600, Wichita, KS 67202  
Character of Well (Completed as Oil, Gas or Dry Hole) \_\_\_\_\_  
Dry Hole  
Date Well completed 4/28/83 19  
Application for plugging filed 4/28/83 19  
Application for plugging approved 4/28/83 19  
Plugging commenced 4/28/83 19  
Plugging completed 4/28/83 19  
Reason for abandonment of well or producing formation \_\_\_\_\_  
Dry Hole  
If a producing well is abandoned, date of last production \_\_\_\_\_  
N/A 19  
Was permission obtained from the Conservation Division or its agents before plugging was commenced? yes

Name of Conservation Agent who supervised plugging of this well Robert Tarbutton, Dodge City  
Producing formation N/A Depth to top N/A Bottom N/A Total Depth of Well 5,700  
Show depth and thickness of all water, oil and gas formations.

OIL, GAS OR WATER RECORDS

CASING RECORD

| FORMATION | CONTENT   | FROM | TO    | SIZE   | PUT IN | PULLED OUT |
|-----------|-----------|------|-------|--------|--------|------------|
|           | Conductor | 0    | 20'   |        | yes    | no         |
|           | Surface   | 0    | 1254' | 8 5/8" | yes    | no         |
|           |           |      |       |        |        |            |
|           |           |      |       |        |        |            |

Describe in detail the manner in which the well was plugged, indicating where the mud flow was placed and the method or methods used in introducing it into the hold. If cement or other plugs were used, state the character of same and depth placed, from \_\_\_\_\_ feet to \_\_\_\_\_ feet for each plug set.

1st Plug @ 1320' 50 sx  
2nd Plug @ 630' 40 sx  
40' to -3' 10 sx  
Rathole 15 sx  
Mousehole 10 sx

Job completed @ 7:00 p.m. on 4/28/83

(If additional description is necessary, use BACK of this sheet)

Name of Plugging Contractor Rine Drilling Company

STATE OF KANSAS COUNTY OF SEDGWICK, ss.  
E. J. RINE (~~employee of owner~~) or (owner or operator of the above-described well, being first duly sworn on oath, says: That I have knowledge of the facts, statements, and matters herein contained and the log of the above-described well as filed and that the same are true and correct. So help me God.

(Signature) [Signature] E. J. RINE, PRESIDENT  
300 West Douglas, Suite 600, Wichita, KS 672  
(Address)

SUBSCRIBED AND SWORN TO before me this 4th day of May, 19 83.

My commission expires January 21, 1985

[Signature]  
Donna K. McKee, Notary Public.

RECEIVED  
STATE CORPORATION COMMISSION

MAY 12 1983

CONSERVATION DIVISION  
Wichita, Kansas