

15-025-20116-00-00


STATE OF KANSAS
STATE CORPORATION COMMISSION
CONSERVATION DIVISION
WICHITA, KANSAS

FORM CP-4

WELL PLUGGING RECORD

New Address
245 North Water
Wichita, Kansas 67202

Clark County, Sec. 12 Twp. 31S Rge. 25W (E) (W)

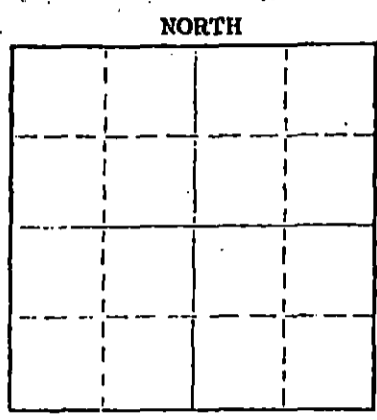

Locate well correctly on above Section Plot

Location as "NE/CNW/SE" or footage from lines _____
 Lease Owner PICKRELL DRILLING COMPANY
 Lease Name ESHELMAN "A"
 Office Address 205 LITWIN BLDG., WICHITA, KS. 67202 Well No. 1
 Character of Well (completed as Oil, Gas or Dry Hole) Dry Hole
 Date well completed 7-24-76 19__
 Application for plugging filed 7-24-76 19__
 Application for plugging approved 7-24-76 19__
 Plugging commenced 7-24-76 19__
 Plugging completed 7-24-76 19__
 Reason for abandonment of well or producing formation Dry Hole

If a producing well is abandoned, date of last production _____ 19__
 Was permission obtained from the Conservation Division or its agents before plugging was commenced? Yes

Name of Conservation Agent who supervised plugging of this well Clarence Thomas, Jr.
 Producing formation _____ Depth to top _____ Bottom _____ Total Depth of Well 5620 Feet
 Show depth and thickness of all water, oil and gas formations.

OIL, GAS OR WATER RECORDS RECEIVED

CASING RECORD

FORMATION	CONTENT	FROM	TO	SIZE	PUT IN	PULLED OUT
STAFF	7-24-76			8 5/8	332	None

Describe in detail the manner in which the well was plugged, indicating where the mud fluid was placed and the method or methods used in introducing it into the hole. If cement or other plugs were used, state the character of same and depth placed, from _____ feet to _____ feet for each plug set.

45 sacks at 300'
 Left top hole open 2:00PM

Name of Plugging Contractor PICKRELL DRILLING COMPANY (If additional description is necessary, use BACK of this sheet)
 Address 205 LITWIN BLDG., WICHITA, KS. 67202

STATE OF KANSAS COUNTY OF SEDGWICK ss.
C.W. SEBITS

(employee of owner) or (owner or operator) of the above-described well, being first duly sworn on oath, says: That I have knowledge of the facts, statements, and matters herein contained and the log of the above-described well as filed and that the same are true and correct. So help me God.

(Signature) C.W. SEBITS
PARTNER

Subscribed and sworn to before me this 28 day of July 1976

My commission expires _____
Jo Ann Sarver
 Jo Ann Sarver Notary Public.



ROTARY DRILLING LOG

COMPANY: PICKRELL DRILLING COMPANY
 205 LITWIN BLDG.
 WICHITA, KS. 67202

LOCATION: Eshelman "A" #1
 C SE SE 12-31S-25W
 Clark Co., Ks.

CONTRACTOR: **PICKRELL DRILLING COMPANY**
Wichita, Kansas

Rotary Drilling Commenced 7-07-76
 Rotary Drilling Completed 7-24-76

15-025-20116-0000

CASING RECORD: Set surface casing at 332' with 225 sx. Comp. 7-8-76 at 3:30AM

LOG

(Figures indicate bottom of formation — measurements from top of rotary bushing.)

Top Soil	560	Lime & Shale	5427
Shale	657	Lime & Shale	5475
Shale	764	Lime & Shale	5490
Shale	781	Lime	5510
Red Bed	1035	Lime & Shale	5551
Shale	1059	Lime & Shale	5600
Shale	1085	Lime	5620
Shale	1274		
Shale	1330		
Shale	1830		
Shale & Lime Stkrs.	1847		
Shale & Lime Stkrs.	2030		
Lime & Shale	2281		
Lime & Shale	2546		
Lime & Shale	2721		
Lime & Shale	2879		
Lime & Shale	2984		
Lime & Shale	3128		
Lime & Shale	3275		
Lime & Shale	3433		
Lime & Shale	3572		
Lime & Shale	3665		
Lime & Shale	3801		
Lime & Shale	3963		
Lime & Shale	4150		
Lime & Shale	4269		
Lime & Shale	4417		
Lime	4562		
Lime & Shale	4660		
Lime & Shale	4762		
Lime & Shale	4872		
Lime & Shale	4962		
Lime	5039		
Lime & Shale	5102		
Lime & Shale	5163		
Lime	5228		
Lime & Shale	5301		
Lime & Shale	5366		

The undersigned, C. W. Sebitts, Attorney-in-Fact for PICKRELL DRILLING COMPANY, hereby certifies in behalf of said Company, that the above is a true and correct log of the formation encountered in drilling the above well as reflected by the Daily Drilling Reports.

PICKRELL DRILLING COMPANY
 By: *C. W. Sebitts*
 C. W. Sebitts, Attorney-in-Fact

STATE OF KANSAS }
 COUNTY OF SEDGWICK } ss.:

On this 28 day of July, 1976, before me the undersigned, a Notary Public, in and for the County and State aforesaid, personally appeared C. W. Sebitts, to me known to be the identical person who subscribed the name of PICKRELL DRILLING COMPANY to the foregoing instrument as its Attorney-in-Fact and acknowledged to me that he executed the same as his free and voluntary act and deed, and as the free and voluntary act and deed of such company, for the uses and purposes therein set forth.

Given under my hand and seal of office the day and year last above written.

My commission expires: _____



Jo Ann Sarver
 Notary Public
 Jo Ann Sarver