


STATE OF KANSAS
STATE CORPORATION COMMISSION

15-025-2055-0000

WELL PLUGGING RECORD

Give All Information Completely
Make Required Affidavit
Mail or Deliver Report to
Conservation Division
State Corporation Comm.
245 North Water
Wichita, KS 67202

Clark County, Sec. 33 Twp. 31S Rge. 25W E/W
Location as "NE/CNW $\frac{1}{4}$ /SW $\frac{1}{4}$ " or footage from lines SE NW
Lease Owner PICKRELL DRILLING COMPANY
Lease Name BACON "HH" Well No. 1
Office Address 205 LITWIN BLDG., WICHITA, KS. 67202
Character of Well (Completed as Oil, Gas or Dry Hole) Dry Hole

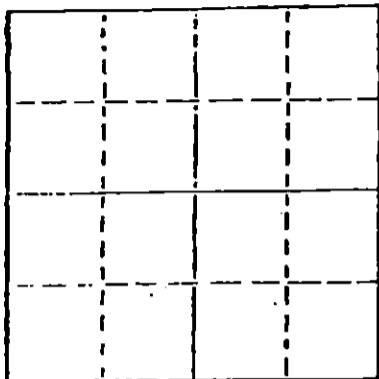

Locate well correctly on above
Section Plat

Date Well completed 5-19-77 19
Application for plugging filed 5-19-77 19
Application for plugging approved 5-19-77 19
Plugging commenced 5-19-77 19
Plugging completed 5-19-77 19
Reason for abandonment of well or producing formation Dry Hole

If a producing well is abandoned, date of last production 19

Was permission obtained from the Conservation Division or its agents before plugging was commenced? Yes

Name of Conservation Agent who supervised plugging of this well Clarence Thomas
Producing formation _____ Depth to top _____ Bottom _____ Total Depth of Well 5650
Show depth and thickness of all water, oil and gas formations.

OIL, GAS OR WATER RECORDS

CASING RECORD

FORMATION	CONTENT	FROM	TO	SIZE	PUT IN	PULLED OUT
				8 5/8	667	None

Describe in detail the manner in which the well was plugged, indicating where the mud fluid was placed and the method or methods used in introducing it into the hold. If cement or other plugs were used, state the character of same and depth placed, from _____ feet to _____ feet for each plug-set.

40 sacks at 635'

10 sacks at 40'

Job comp. @ 4AM 5-20-77

RECEIVED

STATE CORPORATION COMMISSION

MAY 26 1977

CONSERVATION DIVISION
Wichita, Kansas

(If additional description is necessary, use BACK of this sheet)

Name of Plugging Contractor PICKRELL DRILLING COMPANY

STATE OF KANSAS COUNTY OF SEDGWICK, ss.
C. W. Sebitts (employee of owner) or (owner or operator)

of the above-described well, being first duly sworn on oath, says: That I have knowledge of the facts, statements, and matters herein contained and the log of the above-described well as filed and that the same are true and correct. So help me God. BY: C. W. Sebitts

(Signature)

205 Litwin Bldg. Wichita, Ks. 67202

(Address)

SUBSCRIBED AND SWORN TO before me this 25 day of May, 1977



My commission expires

Jo Ann Sarver

Notary Public.

ROTARY DRILLING LOG

COMPANY: PICKRELL DRILLING COMPANY
205 LITWIN BLDG.
WICHITA, KS. 67202
LOCATION: BACON "HH" #1
SE NW Sec. 33-31S-25W
Clark Co., Ks.

Rotary Drilling Commenced 5-6-77
Rotary Drilling Completed 5-19-77

15-025-20155-0000

CONTRACTOR: **PICKRELL DRILLING COMPANY**
Wichita, Kansas

CASING RECORD: Surface casing of 8 5/8" set at 667' w/350 sx. Comp. 5-6-77 9:15PM

LOG

(Figures indicate bottom of formation — measurements from top of rotary bushing.)

TS Shale Sd Redbed	290
Shale	672
Shale	842
Shale	1542
Shale & Shells	2069
Lime & Shale	2210
Lime & Shale	2305
Lime & Shale	2505
Lime & Shale	2630
Lime & Shale	2796
Lime & Shale	2961
Lime & Shale	3102
Lime & Shale	3275
Lime & Shale	3490
Lime & Shale	3674
Lime & Shale	3867
Lime & Shale	4050
Lime & Shale	4157
Lime & Shale	4252
Lime & Shale	4300
Lime & Shale	4350
Lime & Shale	4520
Lime & Shale	4626
Lime & Shale	4744
Lime & Shale	4827
Lime & Shale	4920
Lime & Shale	4984
Lime	5059
Lime & Shale	5125
Lime & Shale	5186
Lime	5256
Lime & Shale	5293
Lime & Shale	5348
Lime	5408
Lime & Shale	5470
Lime & Shale	5500
Lime & Shale	5650

RECEIVED
STATE CORPORATION COMMISSION
MAY 26 1977
CONSERVATION DIVISION
Wichita, Kansas

The undersigned, C. W. Sebitts, Attorney-in-Fact for PICKRELL DRILLING COMPANY, hereby certifies in behalf of said Company, that the above is a true and correct log of the formation encountered in drilling the above well as reflected by the Daily Drilling Reports.

PICKRELL DRILLING COMPANY
By [Signature]
Attorney-in-Fact
C. W. Sebitts

STATE OF KANSAS }
COUNTY OF SEDGWICK } ss.:

On this 25 day of May, 1977, before me the undersigned, a Notary Public, in and for the County and State aforesaid, personally appeared C. W. Sebitts

, to me known to be the identical person who subscribed the name of PICKRELL DRILLING COMPANY to the foregoing instrument as its Attorney-in-Fact and acknowledged to me that he executed the same as his free and voluntary act and deed, and as the free and voluntary act and deed of such company, for the uses and purposes therein set forth.

Given under my hand and seal of office the day and year last above written.



My commission expires:

[Signature]
Notary Public
Jo Ann Sarver