

STATE OF KANSAS  
STATE CORPORATION COMMISSION

WELL PLUGGING RECORD

15-119-00207-0000

Give All Information Completely  
Make Required Affidavit  
Mail or Deliver Report to  
Conservation Division  
State Corporation Comm.  
245 North Water  
Wichita, KS 67202

Meade County, Sec. 3 Twp. 31 Rge. 26W E/W  
Location as "NE/CNW $\frac{1}{4}$ SW $\frac{1}{4}$ " or footage from lines  
C' NW SW

Lease Owner Par Petro., Inc.  
Lease Name Cherry Well No. 1

Office Address Box 280 Liberal, Kansas 67901  
Character of Well (Completed as Oil, Gas or Dry Hole)

Gas well

Date Well completed November 3, 1964

Application for plugging filed February 20, 1979

Application for plugging approved 2-23 1979

Plugging commenced 4-25 1979


Plugging completed 4-26 1979

Reason for abandonment of well or producing formation  
Well has watered out.

If a producing well is abandoned, date of last production  
February 10, 1979

Was permission obtained from the Conservation Division or  
its agents before plugging was commenced? Yes

Name of Conservation Agent who supervised plugging of this well Clarence Thomas  
Producing formation Lansing Depth to top 4531' Bottom 4539' Total Depth of Well 5750  
Show depth and thickness of all water, oil and gas formations.

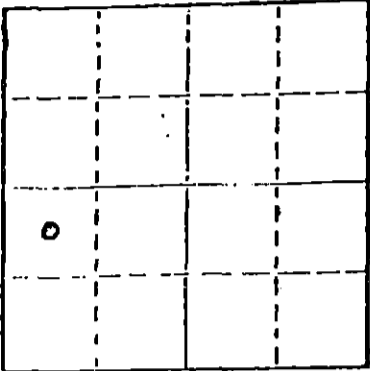

Locate well correctly on above  
Section Plot

OIL, GAS OR WATER RECORDS

CASING RECORD

FORMATION	CONTENT	FROM	TO	SIZE	PUT IN	PULLED OUT
Stone Corral	None	1510'	1540'	8 5/8	1538	none
Lansing	Gas	4531'	4539'	5 1/2	5041	3230
Kansas City	Gas & Water	4890'	4915'			

Describe in detail the manner in which the well was plugged, indicating where the mud fluid was placed and the method or methods used in introducing it into the hold. If cement or other plugs were used, state the character of same and depth placed, from \_\_\_\_\_ feet to \_\_\_\_\_ feet for each plug set.

Pump 20 sks. of cement @ 4636 to 4400  
Pump 35 sks. of cement @ 1500 to 14  
Put 10 sks. of cement @ 40 to 0

RECEIVED  
STATE CORPORATION COMMISSION  
MAY 22 1979

CONSERVATION DIVISION

(If additional description is necessary, use BACK of this sheet.)

Name of Plugging Contractor Sargent's Casing Pulling Service Kansas No. 511

STATE OF Kansas COUNTY OF Seward, ss.  
Ralph M. Reynolds (employee of owner) or (owner or operator)

of the above-described well, being first duly sworn on oath, says: That I have knowledge of the facts, statements, and matters herein contained and the log of the above-described well as filed and that the same are true and correct. So help me God.

(Signature) Ralph M. Reynolds Ralph M. Reynolds  
P. O. Box 280, Liberal, Kansas 67901  
(Address)

SUBSCRIBED AND SWORN TO before me this 21 day of MAY, 1979

My commission expires 1-15-83  
Jaym Easley Notary Public.