


Give All Information Completely
Make Required Affidavit
Mail or Deliver Report to:
Conservation Division
State Corporation Commission
212 No. Market
Wichita, Kansas

WELL PLUGGING RECORD 15-19-30073-0000

NORTH

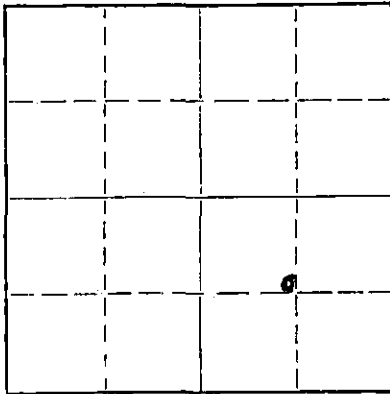

Locate well correctly on above Section Plat

Meade County. Sec. 4 Twp. 31S Rge. 26 (E) (W)^X
Location as "NE/CNW/SW" or footage from lines 1250 ESL, 1250 FEL, Sec 4 C SE/4
Lease Owner Burk Royalty Co.
Lease Name Lang Well No. 1
Office Address 800 Oil & Gas Bldg., Wichita Falls, Texas
Character of Well (completed as Oil, Gas or Dry Hole) Dry
Date well completed 3-23 19 66
Application for plugging filed 3-31 19 66
Application for plugging approved 3-23 19 66
Plugging commenced 3-23 19 66
Plugging completed 3-23 19 66
Reason for abandonment of well or producing formation dry

If a producing well is abandoned, date of last production - 19 -
Was permission obtained from the Conservation Division or its agents before plugging was commenced? yes

Name of Conservation Agent who supervised plugging of this well Ed Eves
Producing formation none Depth to top - Bottom - Total Depth of Well 5198 Feet
Show depth and thickness of all water, oil and gas formations.

OIL, GAS OR WATER RECORDS

CASING RECORD

FORMATION	CONTENT	FROM	TO	SIZE	PUT IN	PULLED OUT
		Conductor		20"	50	none
		Surface		8 5/8"	1574	none

Describe in detail the manner in which the well was plugged, indicating where the mud fluid was placed and the method or methods used in introducing it into the hole. If cement or other plugs were used, state the character of same and depth placed, from 700 feet to 600 feet for each plug set.

Hole was filled with drilling mud. Drill pipe was run in hole to 700'. Halliburton pumped 35 sacks cement spotting at 700' back to 600'. Drill pipe was layed down to 45'. Hole filled with mud. Halliburton pump 15 sacks cement spotted 45' back to surface level.

RECEIVED
STATE CORPORATION COMMISSION

APR 14 1966

CONSERVATION DIVISION
Wichita, Kansas

(If additional description is necessary, use BACK of this sheet)

Name of Plugging Contractor Halliburton
Address P. O. Box 1431 Duncan, Oklahoma

STATE OF Texas COUNTY OF Wichita, ss.
E. C. Cusenbary (employee of owner) or (owner or operator) of the above-described well, being first duly sworn on oath, says: That I have knowledge of the facts, statements, and matters herein contained and the log of the above-described well as filed and that the same are true and correct. So help me God.

(Signature) E. C. Cusenbary
BURK ROYALTY CO.
800 Oil & Gas Bldg., Wichita Falls, Texas
(Address)

SUBSCRIBED AND SWORN TO before me this 12 day of April, 19 66.

Lois Ware Lois Ware
Notary Public.

My commission expires June 1, 1967

DRILLER'S LOG
 BURK ROYALTY COMPANY
 LANG NO. 1
 SEC. 4, TOWNSHIP 31 S, RANGE 26 W
 MEADE COUNTY, KANSAS

15-119-30573-0000

RECEIVED
 STATE GEOLOGICAL COMMISSION

APR 1 1966

CONSERVATION DIVISION
 STATE OF KANSAS

<u>Formation</u>	<u>From</u>	<u>To</u>
Sand, redbed & gyp	0	528
Redbed & Anhydrite	528	1030
Sand & Anhydrite	1030	1390
Redbed, Anhydrite & gyp	1390	1575
Anhydrite & Redbed	1575	2401
Shale & Anhydrite	2401	2989
Lime & chalk	2989	3809
Shale & lime	3809	4050
Lime & shale	4050	4260
Shale & lime	4260	4380
Lime & shale	4380	4455
Shale, lime & chalk	4455	4577
Lime	4577	5152
Lime & shale	5152	5165
Lime	5165	5198
Total Depth		5198 SLM

CERTIFIED TRUE AND CORRECT


MORAN BROS., INC.

By 
 T. E. Swift

PLUGGING AFFIDAVIT:

The above well was plugged on March 23, 1966, by placing 45 sacks of Pozmix in the interval from 600 ft. to 700 ft. and pumping 15 sacks of Pozmix in from 0 ft. to 45 ft.

MORAN BROS., INC.

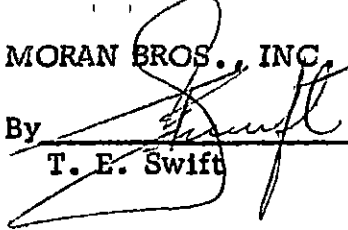By 
 T. E. Swift