


STATE OF KANSAS  
STATE CORPORATION COMMISSION

15-119-26180-0000

Form CP-4

Give All Information Completely  
Make Required Affidavit  
Mail or Deliver Report to:  
Conservation Division  
State Corporation Commission  
P. O. Box 17027  
Wichita, Kansas 67217  
NORTH

WELL PLUGGING RECORD

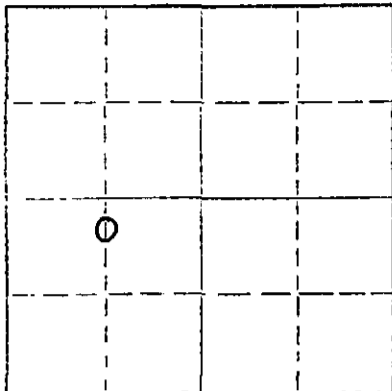

Locate well correctly on above Section Plat

Meade County, Sec. 10 Twp. 31 Rge. (E) 26 (W)  
Location as "NE/CNW/SE/SW" or footage from lines. 2310' FSL 1320' FWL  
Lease Owner CIG Exploration, Inc.  
Lease Name E. Penka Well No. 1  
Office Address 415 W. 8th St.-Suite 300, Amarillo, Texas 79101  
Character of Well (completed as Oil, Gas or Dry Hole) Lost hole  
Date well completed 9/12 19 74  
Application for plugging filed 9/9 19 74  
Application for plugging approved 9/12 19 74  
Plugging commenced 9/12 19 74  
Plugging completed 9/12 19 74  
Reason for abandonment of well or producing formation  
Could not recover drill collars lost in hole (10)  
If a producing well is abandoned, date of last production 19  
Was permission obtained from the Conservation Division or its agents before plugging was commenced? Yes

Name of Conservation Agent who supervised plugging of this well Mr. Clarence Thomas  
Producing formation None Depth to top Bottom Total Depth of Well 772 Feet  
Show depth and thickness of all water, oil and gas formations.

OIL, GAS OR WATER RECORDS

CASING RECORD

FORMATION	CONTENT	FROM	TO	SIZE	PUT IN	PULLED OUT
Morrison	Water	176	218		None	None

Describe in detail the manner in which the well was plugged, indicating where the mud fluid was placed and the method or methods used in introducing it into the hole. If cement or other plugs were used, state the character of same and depth placed, from feet to feet for each plug set.

Spotted 75 sx cement from 583' to 450' thru drill pipe

Spotted 100 sx cement from 100' to surface thru drill pipe

RECEIVED  
STATE CORPORATION COMMISSION  
SEP 25 1974  
CONSERVATION DIVISION  
Wichita, Kansas

(If additional description is necessary, use BACK of this sheet)

Name of Plugging Contractor Halliburton Services  
Address Liberal, Kansas

STATE OF TEXAS COUNTY OF POTTER, ss.  
W. E. Rawlings (employee of owner) or (owner or operator) of the above-described well, being first duly sworn on oath, says: That I have knowledge of the facts, statements, and matters herein contained and the log of the above-described well as filed and that the same are true and correct. So help me God.

(Signature) *W E Rawlings*  
415 W. 8th St.-Suite 300, Amarillo, Texas 79101  
(Address)

SUBSCRIBED AND SWORN to before me this 23rd day of September, 19 74

My commission expires June 1, 1975

*Patricia Mann*  
Notary Public.