

STATE OF KANSAS
STATE CORPORATION COMMISSION


Give All Information Completely
Make Required Affidavit
Mail or Deliver Report to:
Conservation Division
State Corporation Commission
212 No. Market
Wichita, Kansas

WELL PLUGGING RECORD

Clark County, Sec. 3 Twp. 31S Rge. 21 (E) W (W)

Location as "NE/CNW/SW" or footage from lines C SE NW
Lease Owner Frank J. Black
Lease Name Strodman Well No. 1
Office Address McPherson, Kansas
Character of Well (completed as Oil, Gas or Dry Hole) Gas
Date well completed 10-24-55 19
Application for plugging filed 5-20-66 19
Application for plugging approved 5-24-66 19
Plugging commenced 5-27-66 19
Plugging completed 5-20-66 19
Reason for abandonment of well or producing formation Depleted.

T - 31S NORTH R - 21W

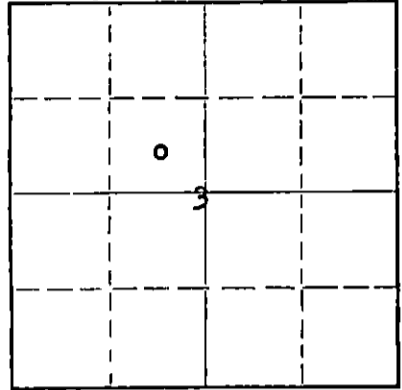

Locate well correctly on above Section Plat

If a producing well is abandoned, date of last production _____ 19____
Was permission obtained from the Conservation Division or its agents before plugging was commenced? yes

Name of Conservation Agent who supervised plugging of this well Eves
Producing formation _____ Depth to top _____ Bottom _____ Total Depth of Well 5218 Feet
Show depth and thickness of all water, oil and gas formations.

OIL, GAS OR WATER RECORDS

CASING RECORD

FORMATION	CONTENT	FROM	TO	SIZE	PUT IN	PULLED OUT
				20"	110'	None
				5-1/2"	5195'	3392'

Describe in detail the manner in which the well was plugged, indicating where the mud fluid was placed and the method or methods used in introducing it into the hole. If cement or other plugs were used, state the character of same and depth placed, from _____ feet to _____ feet for each plug set.

Checked hole to 5200', sanded hole to 5180' and dumped 5 sacks of cement @ 5180' with dump bailer. Pulled 5 1/2" casing to 600' and pumped in 30 sacks of cement. Pulled balance of 5 1/2" casing, set rock bridge @ 140' and dumped 40 sacks of cement. Mudded hole to 15', set rock bridge and ran 30 sacks of cement to base of cellar.

RECEIVED
STATE CORPORATION COMMISSION

JUN 13 1966

CONSERVATION DIVISION
Wichita, Kansas

PLUGGING COMPLETE.

(If additional description is necessary, use BACK of this sheet)

Name of Plugging Contractor KNIGHT CASING PULLING COMPANY License #436
Address CHASE, KANSAS

STATE OF KANSAS, COUNTY OF RICE, ss.
Noel J. Knight (employee of owner) or (~~owner~~) of the above-described well, being first duly sworn on oath, says: That I have knowledge of the facts, statements, and matters herein contained and the log of the above-described well as filed and that the same are true and correct. So help me God.

(Signature) Noel J. Knight
Chase, Kansas
(Address)

SUBSCRIBED AND SWORN to before me this 2nd day of June, 19 66

My commission expires May 20, 1968

Milton J. Volin
Notary Public.


WELL LOG BUREAU--KANSAS GEOLOGICAL SOCIETY
508 East Murdock, Wichita, Kansas

Company STEARNS PETROLEUM, INC.
Farm- Strodtman No. 1

SEC. 3 T. 31 R. 21W
C SE NW

Total Depth. 5218
Ccomm. 9-29-55 Date 10-24-55
Shot or Treated.
Contractor. Trans Era Petroleum, Inc.
Issued. 1-7-56

County Clark
KANSAS

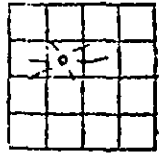

Elevation. 2252

Production. 3,900,000 CFQPD

CASING:

20 in. 110' w/ 200 sx cmt.
5 1/2 5195' w/ 100 sx cmt.


sand	30
shale & shells	109
reaming hole 40 to	114
red bed & shale	1190
red bed, shale & shells	1775
anhydrite & shale	1890
shale & shells	2150
shale & salt	2220
shale, shells & gyp	2260
lime & gyp	2275
gyp & shale	2408
broken lime	2520
gyp & shale streaks	2600
gyp & pyrite	2625
lime	2670
lime & gyp	2720
shale & lime	2765
lime	2875
lime & shale	2925
lime	3015
lime & shale	3890
lime	3960
shale & lime	4507
lime	4655
lime & shale	4698
lime	4757
lime & shale	4805
lime	4850
lime & shale	5000
lime, shale & chert	5018
cherty lime	5050
lime & shale	5100
shale & cherty lime	5118
lime & shale	5177
cored	5218
Total Depth	

SCOUT TOPS:

Brown lime	4485
Lansing	4503
Base K. C.	4951
Cherokee	5093
Mississippi	5192

RECEIVED
STATE CORPORATION COMMISSION

JUN 13 1966

CONSERVATION DIVISION
Wichita, Kansas