


WELL PLUGGING RECORD

Give All Information Completely  
Make Required Affidavit  
Mail or Deliver Report to:  
Conservation Division  
State Corporation Commission  
800 Bitting Building  
Wichita, Kansas

NORTH

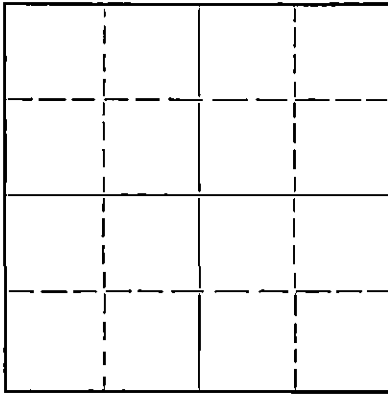

Locate well correctly on above  
Section Flat

Clark County, Sec. 3 Twp. 31 Rge. (E) 21 (W)  
Location as "NE/CNW $\frac{1}{4}$ /SW $\frac{1}{4}$ " or footage from lines NENENE  
Lease Owner Saturn Drilling, Inc.  
Lease Name Yeoman Well No. 1  
Office Address 535 Petroleum Bldg.  
Character of Well (completed as Oil, Gas or Dry Hole) Dry  
Date well completed 4-26 19 53  
Application for plugging filed 4-26 19 53  
Application for plugging approved 4-26 19 53  
Plugging commenced 4-26 19 53  
Plugging completed 4-26 19 53  
Reason for abandonment of well or producing formation Dry

If a producing well is abandoned, date of last production \_\_\_\_\_ 19\_\_\_\_\_  
Was permission obtained from the Conservation Division or its agents before plugging was commenced? Yes

Name of Conservation Agent who supervised plugging of this well Mr. Rizes, Pratt, Kansas  
Producing formation \_\_\_\_\_ Depth to top \_\_\_\_\_ Bottom \_\_\_\_\_ Total Depth of Well 5299 Feet  
Show depth and thickness of all water, oil and gas formations.

OIL, GAS OR WATER RECORDS

CASING RECORD

Formation	Content	From	To	Size	Put In	Pulled Out

Describe in detail the manner in which the well was plugged, indicating where the mud fluid was placed and the method or methods used in introducing it into the hole. If cement or other plugs were used, state the character of same and depth placed, from \_\_\_\_\_ feet to \_\_\_\_\_ feet for each plug set.

Circulated thick rotary mud at total depth.  
Filled hole to depth of 400' with thick rotary mud and placed plug at 390'  
and ~~pl~~ bridged with hulls. Mixed 25 sacks of cement and cemented through  
13 joints of drill pipe.  
Filled hole to depth of 20' with rotary mud and placed plug at depth of  
20' and cemented to cut off point with 10 sacks

(If additional description is necessary, use BACK of this sheet)

Name of Plugging Contractor \_\_\_\_\_  
Address \_\_\_\_\_

STATE OF KANSAS, COUNTY OF SEDGWICK, ss.  
John W. McKnab (employee of owner) or (owner or operator) of the above-described well,  
being first duly sworn on oath, says: That I have knowledge of the facts, statements, and matters herein contained and the log of the above-described well as filed and that the same are true and correct. So help me God.  
(Signature) [Signature]  
535 Petroleum Bldg., Wichita, Kansas  
(Address)

SUBSCRIBED AND SWORN to before me this 29th day of April, 19 53.  
[Signature] Notary Public.

My commission expires Nov. 21, 1956

28-8390-s 6-51-20M

RECEIVED  
STATE CORPORATION COMMISSION  
MAY - 5 1953 5-5-53  
CONSERVATION DIVISION  
Wichita, Kansas

PLUGGING  
FILE SEC 2 T 31 R 21  
BOOK PAGE 92 LINE 8

COMPANY - Saturn Drilling, Inc.

SEC 3, T. 31, R. 21W

NENENE

FARM - Yeoman

CLARK COUNTY, KANSAS

TOTAL DEPTH - 5299

15-025-00088-00-00

COMM. 3/24/53

COMP. 4/26/53

ELEVATION - 2254 D.F.

CASING - 31-3/8" 400' 10-3/4" 1016'

Sand and shale	180
Red shale	365
Lime	400
Sand	478
Shale	1175
Shale and shells	1280
Shale & lime shells	1400
Shale	1810
Salt	1985
Shale	2040
Shale & shells	2205
Shale	2250
Lime and shale	2790
Broken lime	2860
Lime	2940
Broken lime	2985
Sticky lime	3080
Lime	3125
Broken lime	3185
Lime & shale	3240
Broken lime	3345
Shale & lime	3400
Lime & shale stks	3440
Sticky lime	3495
Sticky lime & shale	3530
Sticky lime	3545
Broken lime & shale	3580
Lime and shale	3882
Lime	4025
Lime & shale	4490
Lime	4510
Lime & shale	4580
Hard lime	4600
Chirty lime	4608
Hard lime	4615
Lime & shale	4709
Lime	4802
Lime & shale	4840
Broken lime	4945
Hard lime & shale	4955
Lime & shale	4975
Broken lime	5020
Shale & lime	5050
Shale	5072
Broken lime & shale	5097
Lime & shale	5199
Lime	5225
Lime & shale	5238
Lime	5252
Lime & shale	5277
Lime	5299
T.D.	5299

**PLUGGING**  
 FILE SEC 3 T 31 R 21W  
 BOOK PAGE 22 LINE 2

MAY 15 1953  
 CONSERVATION DIVISION  
 Wichita, Kansas