


STATE OF KANSAS  
STATE CORPORATION COMMISSION

15-025-20953-0000

## WELL PLUGGING RECORD

Give All Information Completely  
Make Required Affidavit  
Mail or Deliver Report to  
Conservation Division  
State Corporation Comm.  
245 North Water  
Wichita, KS 67202

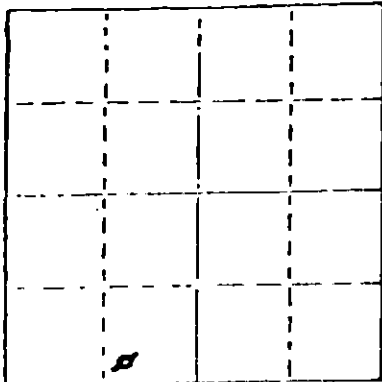

Locate well correctly on above  
Section Plat

Clark County, Sec. 34 Twp. 31 Rge. 22W  
Location as "NE/CNW $\frac{1}{4}$ SW $\frac{1}{4}$ " or footage from lines  
SW-SE-SW 330' ESL, 990' FE L  
Lease Owner Bogert Oil Company  
Lease Name Waits Well No. 1-34  
Office Address 2601 N.W. Expressway, Suite 1000-W OK City  
Character of Well (Completed as Oil, Gas or Dry Hole)  
Dry  
Date Well completed 6/29/86 as D & A 1986  
Application for plugging filed 1-  
Application for plugging approved Yes 1-  
Plugging commenced 6/30/86 1-  
Plugging completed 6/30/86 1-  
Reason for abandonment of well or producing formation  
Dry

If a producing well is abandoned, date of last production 19

Was permission obtained from the Conservation Division or its agents before plugging was commenced? Yes

Name of Conservation Agent who supervised plugging of this well Paul Luthi, Minola, KS  
Producing formation None Depth to top Bottom Total Depth of Well  
Show depth and thickness of all water, oil and gas formations.

## OIL, GAS OR WATER RECORDS

## CASING RECORD

FORMATION	CONTENT	FROM	TO	SIZE	PUT IN	PULLED OUT
		0	680'	8 5/8"	680'	None

Describe in detail the manner in which the well was plugged, indicating where the mud fluid was placed and the method or methods used in introducing it into the hole. If cement or other plugs were used, state the character of same and depth placed, from feet to feet for each plug set. Plugged:

50 Sacks C1 H + 2% CC from 1112' - 1032'  
50 Sacks C1 H + 2% CC 713' - 594'  
30 Sacks C1 H + 2% CC 310' - 222'  
10 Sacks C1 H 40' to Surface  
20 Sacks in Rathole, 30 Sacks in Mousehole, cut off 8 5/8" surface casing  
& weld on steel ID plate

API # 15-025-20,953

(If additional description is necessary, use BACK of this sheet)

Name of Plugging Contractor DaMac Drilling Inc. /Dowell Schlumberger Incorporated

STATE OF OKLAHOMA COUNTY OF OKLAHOMA, ss.  
Gerald W. Smith (employee of owner) or (owner or operator  
of the above-described well, being first duly sworn on oath, says: That I have knowledge of  
the facts, statements, and matters herein contained and the log of the above-described well  
as filed and that the same are true and correct. So help me God.

(Signature) Gerald W. Smith  
2601 NW Expressway, #1001-W, Okla. City, OK 73112  
(Address)

SUBSCRIBED AND SWORN TO before me this 21<sup>st</sup> day of July, 1986

Notary Public expires 10/11/86

7-23-86

JUL 23 1986