


STATE OF KANSAS
STATE CORPORATION COMMISSION

WELL PLUGGING RECORD

15-025-20295-0000

Give All Information Completely
Make Required Affidavit
Mail or Deliver Report to
Conservation Division
State Corporation Comm.
245 North Water
Wichita, KS 67202

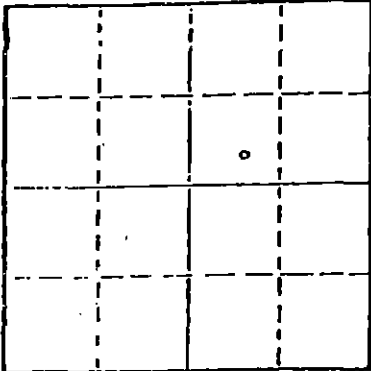

Locate well correctly on above
Section Plot

Clark County. Sec. 35 Twp. 31S Rge. 22W E/W
Location as "NE/CNW $\frac{1}{4}$ SW $\frac{1}{4}$ " or footage from lines 2310' FNL & 1700' FEL
Lease Owner Mesa Petroleum Company
Lease Name Waits Well No. 1-35
Office Address PO Box 1578, Liberal, Kansas 67901
Character of Well (Completed as Oil, Gas or Dry Hole) Dry Hole
Date Well completed 5-26 19 79
Application for plugging filed 19
Application for plugging approved 19
Plugging commenced 5-27 19 79
Plugging completed 5-27 19 79
Reason for abandonment of well or producing formation dry hole
If a producing well is abandoned, date of last production 19

Was permission obtained from the Conservation Division or its agents before plugging was commenced? yes
Name of Conservation Agent who supervised plugging of this well Clarence Thomas
Producing formation Depth to top Bottom Total Depth of Well 5450
Show depth and thickness of all water, oil and gas formations.


OIL, GAS OR WATER RECORDS					CASING RECORD	
FORMATION	CONTENT	FROM	TO	SIZE	PUT IN	PULLED OUT
				8 5/8"	622.16'	none

Describe in detail the manner in which the well was plugged, indicating where the mud fluid was placed and the method or methods used in introducing it into the hold. If cement or other plugs were used, state the character of same and depth placed, from feet to feet for each plug-set. Plugged well as follows: 60 sacks 675'-575'
10 sacks 40'- 3'
5 sacks mouse hole
5 sacks rat hole

RECEIVED
STATE CORPORATION COMMISSION
MAY 30 1979 5-30-79
CONSERVATION DIVISION
Wichita, Kansas

(If additional description is necessary, use BACK of this sheet)
Name of Plugging Contractor Halliburton, Pratt, Kansas

STATE OF Kansas COUNTY OF Seward, ss.
Harold K. Frauli (employee of owner) or (owner or operator)
of the above-described well, being first duly sworn on oath, says: That I have knowledge of the facts, statements, and matters herein contained and the log of the above-described well as filed and that the same are true and correct. So help me God.

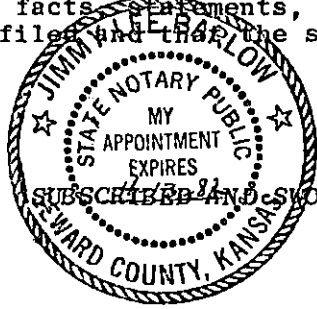

(Signature) Harold K. Frauli, Agent
PO Box 1578, Liberal, Kansas 67901
(Address)
SUBSCRIBED AND SWORN TO before me this 29th day of May, 19 79
Jimmie Lee Barlow
Notary Public.

My commission expires April 13, 1982

WELL LOG

15-02520295-000

COMPANY: Mesa Petroleum Company

SEC. 35 T. 31S W. 22W

FARM: Waits

NO. 1-35

LOC. 2310 FNL 1700 FEL


TOTAL DEPTH: 5450'

COUNTY: Clark

COMM. 5-14-79

COMP. 5-27-79

CONTRACTOR: DaMac Drilling Inc.

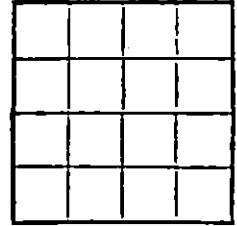

CASING Conductor: 20" set @ 60'
Surface 8 5/8" set @ 620

ELEVATION

PRODUCTION P&A

FIGURES INDICATE BOTTOM OF FORMATIONS

Surface Sand	0	60
RedBed	60	245
RedBed, Shale	245	1805
Shale	1805	2228
Shale, Lime	2228	4745
Lime	4745	5450 RTD

RECEIVED
AMARILLO PRODUCTION

JUN - 4 1979

JLF		GD	
SD	✓	BC	
		TLS	

RECEIVED
STATE CORPORATION COMMISSION

OCT 16 1979

CONSERVATION DIVISION
Wichita, Kansas

State of Kansas }
County of Barton }

I, Martha J. McKown of DaMac Drilling Inc.

upon oath state the above and foregoing is a true and correct copy of the log of the Waits No. 1-35 well.

KG5(2) 6-8-79

Denver
WF. W. J. Owens

Subscribed and sworn to before me this 29th day of May 19 79

My Comm. Expires 4-28-81

LANA L. REMMERT
Barton County, Kansas

Lana L. Remmert XC Stan D
10