

STATE OF KANSAS
STATE CORPORATION COMMISSION


WELL PLUGGING RECORD

15-025-20370-000

Give All Information Completely
Make Required Affidavit
Mail or Deliver Report to
Conservation Division
State Corporation Comm.
245 North Water
Wichita, KS 67202

Clark County, Sec. 6 Twp. 31 Rge. 23W E/W
Location as "NE/CNW $\frac{1}{4}$ SW $\frac{1}{4}$ " or footage from lines
C NW NW

Lease Owner F & M Oil Co., Inc.
Lease Name Wheatley Farms Well No. 1
Office Address 422 Union Center, Wichita, KS
Character of Well (Completed as Oil, Gas or Dry Hole)

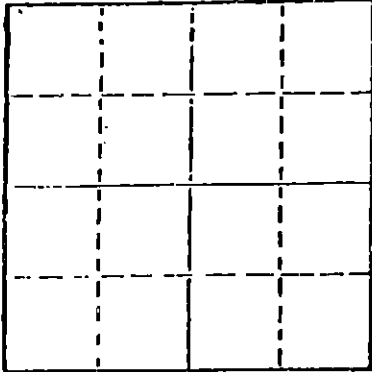

Locate well correctly on above
Section Plot

dry hole
Date Well completed 6-14-80 19
Application for plugging filed 6-14-80 19
Application for plugging approved 6-14-80 19
Plugging commenced 6-14-80 19
Plugging completed 6-14-80 19
Reason for abandonment of well or producing formation
dry

If a producing well is abandoned, date of last production 19

Was permission obtained from the Conservation Division or its agents before plugging was commenced? Yes, verbally

Name of Conservation Agent who supervised plugging of this well Clarence Thomas
Producing formation Depth to top Bottom Total Depth of well 5600
Show depth and thickness of all water, oil and gas formations.

OIL, GAS OR WATER RECORDS

CASING RECORD

FORMATION	CONTENT	FROM	TO	SIZE	PUT IN	PULLED OUT

Describe in detail the manner in which the well was plugged, indicating where the mud fluid was placed and the method or methods used in introducing it into the hold. If cement or other plugs were used, state the character of same and depth placed, from feet to feet for each plug set.

First plug set at 600' with 60 sacks
Second plug set at 40' with 10 sacks
5 sacks in rat hole

RECEIVED
JUL 1980
STATE CORPORATION COMMISSION
WICHITA, KANSAS
7-2-80

(If additional description is necessary, use BACK of this sheet)

Name of Plugging Contractor Gabbert-Jones

STATE OF Kansas COUNTY OF Sedgwick, ss.
E. A. Falkowski (employee of owner) or (owner or operator)
of the above-described well, being first duly sworn on oath, says: That I have knowledge of the facts, statements, and matters herein contained and the log of the above-described well as filed and that the same are true and correct. So help me God.

(Signature) E. A. Falkowski
422 Union Center, Wichita, KS
(Address)

SUBSCRIBED AND SWORN TO before me this 15 day of June, 19 80

My commission expires 6-2-82

Cynthia L. Romey
Cynthia L. Romey Notary Public.

WELL COMPLETION REPORT AND DRILLER'S LOG

S. 6 T. 31 R. 23W E

Loc. C NW NW

County Clark

API No. 15 — 025 — 20,370-0006
County Number

Operator
F & M Oil Co., Inc.

Address
422 Union Center, Wichita, Kansas


Well No. 1 Lease Name Wheatley Farms

Footage Location
660 feet from (N) XX line 660 feet from (E) (W) line

Principal Contractor Gabbert - Jones Geologist Mike Russell

Spud Date 5-30-80 Date Completed 6-13-80 Total Depth 5600 P.B.T.D.

Directional Deviation Oil and/or Gas Purchaser -----

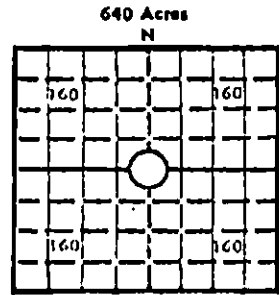

Elev.: Gr. 2550
Locate well correctly

DF 2555 KB 2555

CASING RECORD

Report of all strings set — surface, intermediate, production, etc.

Purpose of string	Size hole drilled	Size casing set (in O.D.)	Weight lbs/ft.	Setting depth	Type cement	Sacks	Type and percent additives
surface	12 1/4"	8-5/8"		613	60-40	350	2% gel, 3% CC

LINER RECORD

PERFORATION RECORD

Top, ft.	Bottom, ft.	Sacks cement	Shots per ft.	Size & type	Depth interval

TUBING RECORD

Size	Setting depth	Packer set at

ACID, FRACTURE, SHOT, CEMENT SQUEEZE RECORD

Amount and kind of material used	Depth interval treated

INITIAL PRODUCTION

Date of first production	Producing method (flowing, pumping, gas lift, etc.)
RATE OF PRODUCTION PER 24 HOURS	Oil <u> </u> Gas <u> </u> Water <u> </u> Gas-oil ratio <u> </u>
Disposition of gas (ventil, used on lease or sold)	Producing interval(s)

STATE CORPORATION COMMISSION
RECEIVED
AUG 15 1980
CONSERVATION DIVISION
Wichita, Kansas

INSTRUCTIONS: As provided in KCC Rule 82-2-125, within 90 days after completion of a well, one completed copy of this Drillers Log shall be transmitted to the State Geological Survey of Kansas, 4150 Monroe Street, Wichita, Kansas 67209. Copies of this form are available from the Conservation Division, State Corporation Commission, 245 No. Water, Wichita, Kansas 67202. Phone AC 316-522-2206. If confidential custody is desired, please note Rule 82-2-125. Drillers Logs will be an open file in the Oil and Gas Division, State Geological Survey of Kansas, Lawrence, Kansas 66044.

Operator F & M Oil Co., INC.		DESIGNATE TYPE OF COMP.: OIL, GAS, DRY HOLE, SWDW, ETC.: dry
Well No. 1	Lease Name Wheatley Farms	
S <u>6</u> T <u>31</u> R <u>23</u> g W		

WELL LOG

Show all important zones of porosity and contents thereof; corad intervals, and all drill-stem tests, including depth interval tested, cushion used, time tool open, flowing and shut-in pressures, and recoveries.

SHOW GEOLOGICAL MARKERS, LOGS RUN, OR OTHER DESCRIPTIVE INFORMATION.

FORMATION DESCRIPTION, CONTENTS, ETC.	TOP	BOTTOM	NAME	DEPTH
DST #1 5347-5416, 30-30-60-10 Very wk. blow, died in 28". No blow on 2nd op. Rec. 70'M. FP 116-116, SIP 560-560			Electric Log Tops: Stark 5062 (-2507) B/KC 5162 (-2607) Marm 5176 (-2621) B/Paw 5306 (-2751) Cher. 5336 (-2781) B/Inola 5416 (-2861) Miss 5440 (-2885)	

USE ADDITIONAL SHEETS, IF NECESSARY, TO COMPLETE WELL RECORD.

Date Received	Signature
	President
	Title
	June 19, 1980
	Date