


15419-2091-00-01

WELL PLUGGING RECORD

Give All Information Completely  
Make Required Affidavit  
Mail or Deliver Report to:  
Conservation Division  
State Corporation Commission  
P. O. Box 17027  
Wichita, Kansas 67217  
NORTH

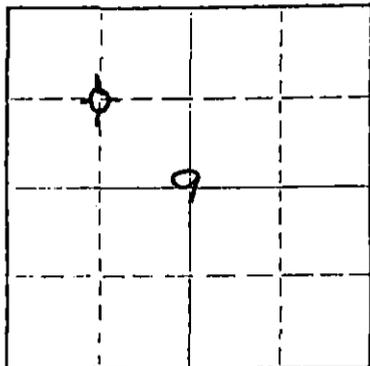

Locate well correctly on above  
Section Plat

Meade County. Sec. 9 Twp. 31 Rge. 27 (E) W (W)  
C NW  
Location as "NE/CNW/SW" or footage from lines  
Lease Owner Lario Oil & Gas Company  
Lease Name Norman Well No. 1-9  
Office Address 301 South Market, Wichita, Kansas 67202  
Character of Well (completed as Oil, Gas or Dry Hole) Dry Hole  
Date well completed \_\_\_\_\_ 19\_\_\_\_  
Application for plugging filed 12-23-77 19\_\_\_\_  
Application for plugging approved 12-27-77 19\_\_\_\_  
Plugging commenced 2-23-78 19\_\_\_\_  
Plugging completed 2-25-78 19\_\_\_\_  
Reason for abandonment of well or producing formation  
Non Productive  
If a producing well is abandoned, date of last production -- 19\_\_\_\_  
Was permission obtained from the Conservation Division or its agents before plugging was commenced? Yes

Name of Conservation Agent who supervised plugging of this well Clarence Thomas  
Producing formation None Depth to top... Bottom... Total Depth of Well 5450 Feet  
Show depth and thickness of all water, oil and gas formations.

OIL, GAS OR WATER RECORDS

CASING RECORD

FORMATION	CONTENT	FROM	TO	SIZE	PUT IN	PULLED OUT
				8 5/8	1399	None
				5 1/2	5448	2813'

Describe in detail the manner in which the well was plugged, indicating where the mud fluid was placed and the method or methods used in introducing it into the hole. If cement or other plugs were used, state the character of same and depth placed, from \_\_\_\_\_ feet to \_\_\_\_\_ feet for each plug set.

Pump 1 sk. of hulls and 10 sks. cement - top @ 3600'  
Pump 50 sks. cement - 1300-1200'  
Pump 10 sks. cement @ 40' to surface  
Cut 8 5/8 below ground level and welded on a cap.

RECEIVED  
STATE CORPORATIONS COMMISSION  
MAR 17 1978  
WICHITA, KANSAS

(If additional description is necessary, use BACK of this sheet)  
Name of Plugging Contractor Sargents Casing Pulling Service  
Address Box 506, Liberal, Kansas 67901

STATE OF Kansas COUNTY OF Sedgwick ss.  
C. T. Slack (employee of owner) or (owner or operator) of the above-described

well, being first duly sworn on oath, says: That I have knowledge of the facts, statements, and matters herein contained and the log of the above-described well as filed and that the same are true and correct. So help me God.

(Signature) C T Slack  
301 South Market, Wichita, Kansas 67202 (Address)

SUBSCRIBED AND SWORN TO before me this 16 day of March, 1978

Marcia Mills  
Notary Public.

My commission expires January 12, 1981

  
**MARCIA MILLS**  
 NOTARY PUBLIC  
 Sedgwick County, Kansas  
 My Appointment Expires 1-12-81