

WELL PLUGGING RECORD

Give All Information Completely
Make Required Affidavit
Mail or Deliver Report to:
Conservation Division
State Corporation Commission
211 No. Broadway
Wichita, Kansas

MEADE County. Sec. 18 Twp. 31S Rge. 27W ~~XXX~~ (W)

Location as "NE/CNW%SW%" or footage from lines SE SE NE

Lease Owner Sierra Petroleum Co., Inc.

Lease Name Edwards Well No. # 1

Office Address 420 West Douglas, Wichita, Kansas

Character of Well (completed as Oil, Gas or Dry Hole) Dry

Date well completed 5/19/57 19

Application for plugging filed 5/18/57 19

Application for plugging approved 5/18/57 19

Plugging commenced 5/19/57 19


Plugging completed 5/19/57 19

Reason for abandonment of well or producing formation Dry

If a producing well is abandoned, date of last production _____ 19

Was permission obtained from the Conservation Division or its agents before plugging was commenced? Yes

NORTH

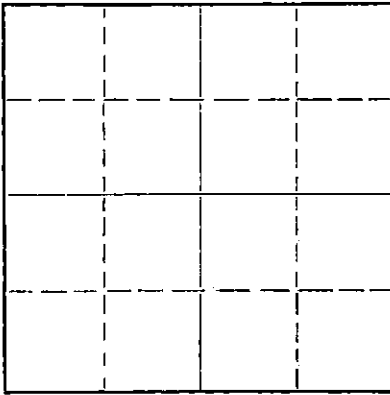

Locate well correctly on above Section Plat

Name of Conservation Agent who supervised plugging of this well M. A. Rives

Producing formation _____ Depth to top _____ Bottom _____ Total Depth of Well 5604' Feet

Show depth and thickness of all water, oil and gas formations.

OIL, GAS OR WATER RECORDS

CASING RECORD

FORMATION	CONTENT	FROM	TO	SIZE	PUT IN	PULLED OUT
				8-5/8"	1392	None

Describe in detail the manner in which the well was plugged, indicating where the mud fluid was placed and the method or methods used in introducing it into the hole. If cement or other plugs were used, state the character of same and depth placed, from _____ feet to _____ feet for each plug set.

PLUGGING REPORT:

Filled hole with heavy mud from 5604' up to 400'. Set Bridge with 1/2 sack hulls and wood plug. Put 30 sacks cement through drill pipe up to 340', top of hole. Left 8-5/8" casing open to accomodate farmer for a water well. Letter of authorization attached. Job completed May 19, 1957 at 2:30 PM.


Name of Plugging Contractor Sierra Petroleum Co., Inc.
Address 420 West Douglas, Wichita, Kansas

STATE OF KANSAS, COUNTY OF RUSSELL, ss.
C. H. Honaker (employee of owner) or (owner or operator) of the above-described well, being first duly sworn on oath, says: That I have knowledge of the facts, statements, and matters herein contained and the log of the above-described well as filed and that the same are true and correct. So help me God.

(Signature) C. P. Honaker
Great Bend, Kansas (Address)

SUBSCRIBED AND SWORN TO before me this 21st day of May, 1957

My commission expires 10/17/59

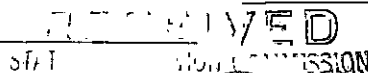

Leroy A. Bieby
Notary Public.

5-23-57

CONSERVATION DIVISION
Wichita, Kansas

PLUGGING
FILE SEC 18 T 31 R 27W
BOOK PAGE 19 LINE 4

15-119-00039-0000

Sierra Petroleum Company, Inc.
EDWARDS #1

SE SE NE Sec. 18-31S-27W
Meade County, Kansas

Total Depth: 5604'

Elev: 2456' KB

Comm: 4/19/57

Comp: 5/19/57

Casing

Cement

8-5/8" Casing set @ 1392'

625 sacks common cement

FORMATION DEPTH

Surface clay & shale	80
Sand	230
Shale	530
Shale & redbed	730
Redbed & Anhydrite	965
Sand & redbed	1040
Redbed	1175
Redbed & shale	1370
Anhydrite	1410
Shale	1850
Shale & shells	2350
Lime & shale	2710
Lime	2800
Lime & shale	2870
Lime	2935
Lime & Cherty	2990
Lime	3175
Chalkylime	3275
Lime 3735	3735
Lime-Chalk & shale	3785
Lime	4190
Chalky lime	4200
Heebner shale	4210
Lime & shale	4229
Lime	4257
Lime & shale	4355
Lime chalky	4388
Lime	4495
Chalky Lime	4525
Lime	5047
Cherty lime	5077
Lime	5257
Sandy lime	5285
Lime	5344
Sand & lime	5389
Mississippian	5415
Lime	5604

TOPS:	Anhydrite	1375
	Topeka	3791
	Hebner	4200
	Kansas City	4357
	Base of Kansas City	5005
	Marmorton	5005
	Morrow	5328
	Mississippi	5380


STATE OF KANSAS)
) ss:
COUNTY OF RUSSELL)

PLUGGING			
FILE	SEC. 18	T. 31	N. 27W
BOOK	PAGE 14	LINE	4

I hereby certify that the above information is true and correct to the best of my knowledge.

C. P. Hansen

Subscribed and sworn to before me this 21st day of May, 1957.

Leroy Dietz

My commission expires: 10/17/59

Notary Public