

15-119-20281-0000


STATE OF KANSAS
STATE CORPORATION COMMISSION

WELL PLUGGING RECORD

Give All Information Completely
Make Required Affidavit
Mail or Deliver Report to
Conservation Division
State Corporation Comm.
245 North Water
Wichita, KS 67202

Meade County, Sec. 23 Twp. 31S Rge. 27 E/W
Location as "NE/CNW 1/4 SW 1/4" or footage from lines

C NW
Lease Owner Price Exploration Company
Lease Name Gerber Well No. #1
Office Address 814 Mayo Bldg., Tulsa, Oklahoma 74103
Character of Well (Completed as Oil, Gas or Dry Hole)

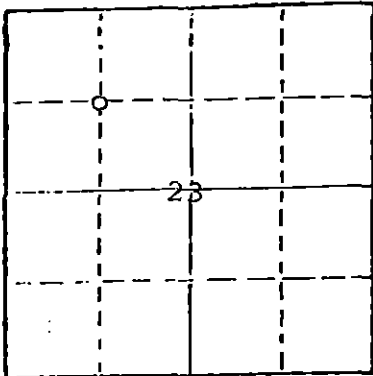

Locate well correctly on above
Section Plat

Dry Hole
Date Well completed 9-13-77 19
Application for plugging filed 9-13-77 19
Application for plugging approved 9-13-77 19
Plugging commenced 9-13-77 19
Plugging completed 9-13-77 19
Reason for abandonment of well or producing formation
Commercial quantities of oil not found
If a producing well is abandoned, date of last production 19

Was permission obtained from the Conservation Division or
its agents before plugging was commenced? Yes

Name of Conservation Agent who supervised plugging of this well Clarence Thomas, Garden City,
Producing formation Depth to top Bottom Total Depth of Well 5715'
Show depth and thickness of all water, oil and gas formations.

OIL, GAS OR WATER RECORDS

CASING RECORD

FORMATION	CONTENT	FROM	TO	SIZE	PUT IN	PULLED OUT
				8 5/8"	1412'	None

Describe in detail the manner in which the well was plugged, indicating where the mud fluid
was placed and the method or methods used in introducing it into the hold. If cement or other
plugs were used, state the character of same and depth placed, from feet to
feet for each plug set.

RECEIVED

Plug @ 1400' w/60 sx.
Plug @ 40' w/15 sx.
Rat Hole 5 sx. SEP 22 1977 9-22-77

CONSERVATION DIVISION
Wichita, Kansas


(If additional description is necessary, use BACK of this sheet)

Name of Plugging Contractor Rains & Williamson Oil Co., Inc.

STATE OF Kansas COUNTY OF Sedgwick, ss.
Wilson Rains, President of Rains & Williamson Oil Co., Inc. (employee of owner) or (owner or operator)
of the above-described well, being first duly sworn on oath, says: That I have knowledge of
the facts, statements, and matters herein contained and the log of the above-described well
as filed and that the same are true and correct. So help me God.

(Signature) Wilson Rains
435 Page Court, 220 W. Douglas, Wichita, Ks. 67201
(Address)

SUBSCRIBED AND SWORN TO before me this 15 day of September, 1977

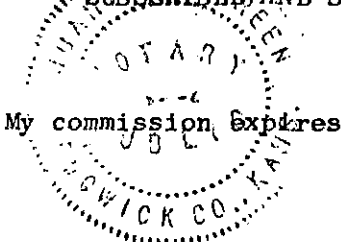

Juanita M. Green
Juanita M. Green Notary Public.

DRILLER'S LOG

15-019-20281-0000

COMPANY: Price Exploration Company

SEC. 23 T. 31S R. 27W

WELL NAME: Gerber #1

LOC. C NW

RIG NO. #8

COUNTY: Meade

TOTAL DEPTH 5715'

ELEVATION

COMMENCED: 8-23-77

COMPLETED: 9-13-77

CONTRACTOR: Rains & Williamson Oil Co., Inc.

CASING RECORD:

SURFACE: 8 5/8" @ 1412' w/550 sx. common and 150 sx. Class H, 2% cc.

PRODUCTION: D&A

LOG

(Figures Indicate Bottom of Formations)

Sand & Redbed	397
Redbed	1412
Shale	2084
Shale & Lime	2530
Lime & Shale	3000
Shale & Lime	3120
Lime & Shale	5573
Lime	5715
<u>ROTARY TOTAL DEPTH</u>	<u>5715</u>

SEP 22 1977

STATE OF Kansas)

COUNTY OF Sedgwick)

SS:

I, Wilson Rains, President of Rains & Williamson Oil Co., Inc.

upon oath state that the above and foregoing is a true and correct copy of the log of the

Gerber #1 well.

Wilson Rains

Wilson Rains

Subscribed and sworn to before me this 15 day of September, 1977.

Juanita M. Green
Juanita M. Green

My Appointment Expires:

10-4-79

