


WELL PLUGGING RECORD

Give All Information Completely
Make Required Affidavit
Mail or Deliver Report to:
Conservation Division
State Corporation Commission
211 No. Broadway
Wichita, Kansas

NORTH

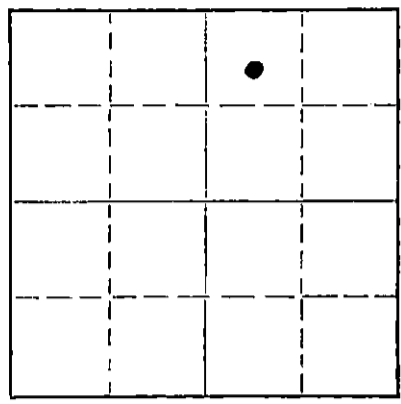

Locate well correctly on above Section Plat

Stevens County. Sec. 1 Twp. 31S Rge. (E) 35 (W)
Location as "NE/CNW/SW" or footage from lines 100' S and 100' E C NW NE
Lease Owner Mobil Oil Corporation
Lease Name Cutter Well No. 5
Office Address P. O. Box 1934, Oklahoma City, Oklahoma
Character of Well (completed as Oil, Gas or Dry Hole) Dry Hole
Date well completed _____ 19____
Application for plugging filed 1-7 19 71
Application for plugging approved 1-12 19 71
Plugging commenced 1-5 19 71
Plugging completed 1-5 19 71
Reason for abandonment of well or producing formation Dry Hole

If a producing well is abandoned, date of last production _____ 19____
Was permission obtained from the Conservation Division or its agents before plugging was commenced? Yes

Name of Conservation Agent who supervised plugging of this well Eddie Eaves
Producing formation None Depth to top _____ Bottom _____ Total Depth of Well 5700 Feet
Show depth and thickness of all water, oil and gas formations.

OIL, GAS OR WATER RECORDS

CASING RECORD

FORMATION	CONTENT	FROM	TO	SIZE	PUT IN	PULLED OUT
None				8-5/8"	665'	None

Describe in detail the manner in which the well was plugged, indicating where the mud fluid was placed and the method or methods used in introducing it into the hole. If cement or other plugs were used, state the character of same and depth placed, from _____ feet to _____ feet for each plug set.

A 35 sack cement plug was placed from 625' to 682' and a 15 sack cement plug was run from 35' to the surface as per instructions of Eddy Eaves with Kansas Corporation Commission.

RECEIVED
STATE CORPORATION COMMISSION
FEB 24 1971
CONSERVATION DIVISION
Wichita, Kansas

(If additional description is necessary, use BACK of this sheet)
Name of Plugging Contractor Lohmann-Johnson Drilling Co.
Address 1701 Fidelity Bank Bldg., Oklahoma City, Oklahoma

STATE OF Oklahoma, COUNTY OF Oklahoma, ss. Paul K. Langenberg (employee of owner) or (owner or operator) of the above-described well, being first duly sworn on oath, says: That I have knowledge of the facts, statements, and matters herein contained and the log of the above-described well as filed and that the same are true and correct. So help me God.

(Signature) Paul K. Langenberg
P. O. Box 1934, Oklahoma City, Oklahoma 73101
(Address)

SUBSCRIBED AND SWORN TO before me this 16 day of February, 19 71

My commission expires 11-17-73

Richard N. Squibb
Notary Public.

MOBIL NO. 5 W. I. CUTTER

Stevens County, Kansas Section 1-31S-35W

15-189-20093-0000

662 - 1170	Sand & Shale
1170 - 1660	Shale
1660 - 1790	Sand
1790 - 2150	Shale
2150 - 2500	Sand
2500 - 3950	Sand & Shale
3950 - 4100	Shale
4100 - 4920	Sand & Limestone
4920 - 5350	Limestone & Shale
5350 - 5380	Sand
5380 - 5570	Limestone & Shale
5570 - 5700	Sand, Shale & Limestone

RECEIVED
STATE CORPORATION COMMISSION
FEB 24 1971
CONSERVATION DIVISION
Wichita, Kansas