


STATE OF KANSAS  
STATE CORPORATION COMMISSION

Give All Information Completely  
Make Required Affidavit  
Mail or Deliver Report to:  
Conservation Division  
State Corporation Commission  
P. O. Box 17027  
Wichita, Kansas 67217  
NORTH

## WELL PLUGGING RECORD

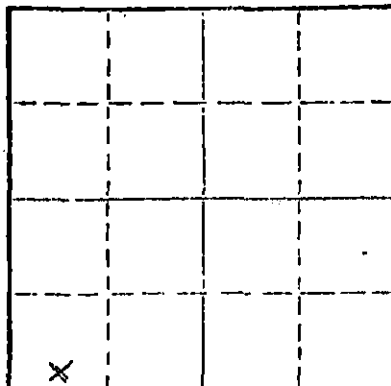

Locate well correctly on above  
Section Plat

Sumner County, Sec 9 Twp. 30 Rge. 2 (E) W (W)  
Location as "NE/CNW/SW" or footage from lines C S/2 SW  
Lease Owner Messman - Rinehart Oil Co.  
Lease Name Love Melia Well No. #3  
Office Address 1432 Wichita Plaza : Wichita, Kansas 67202  
Character of Well (completed as Oil, Gas or Dry Hole)  
Date well completed 19  
Application for plugging filed September 1973  
Application for plugging approved September 1973  
Plugging commenced October 12 1973  
Plugging completed October 16 1973  
Reason for abandonment of well or producing formation

If a producing well is abandoned, date of last production 19  
Was permission obtained from the Conservation Division or its agents before plugging was commenced? Yes

Name of Conservation Agent who supervised plugging of this well Eugene Graham  
Producing formation Depth to top Bottom Total Depth of Well Feet  
Show depth and thickness of all water, oil and gas formations.

## OIL, GAS OR WATER RECORDS

## CASING RECORD

FORMATION	CONTENT	FROM	TO	SIZE	PUT IN	PULLED OUT
				8 5/8"	250	None
				4 1/2"	3115	2490

Describe in detail the manner in which the well was plugged, indicating where the mud fluid was placed and the method or methods used in introducing it into the hole. If cement or other plugs were used, state the character of same and depth placed, from feet to feet for each plug set.

October 12, 1973

Plugged off bottom. Dumped sand to 3000'.  
Mixed and dumped 4 sx of cement.

October 16, 1973

Plugged off top. Set 10' rock bridge at 240'.  
Mixed and dumped 25 sx of cement. Mudded  
8 5/8" casing to 40'. Set 10' rock bridge  
from 40' to 30'. Mixed and dumped 10 sx of  
cement from 30' to base of cellar.

RECEIVED  
STATE CORPORATION COMMISSION  
NOV 19 1973  
CONSERVATION DIVISION  
Wichita, Kansas

(If additional description is necessary, use BACK of this sheet)  
Name of Plugging Contractor RUSS CASING PULLING, INC.  
Address P. O. Box 1082 : Great Bend, Kansas 67530

STATE OF KANSAS, COUNTY OF SEDGWICK ss.  
J. A. Gilliland (employee of owner) or (owner or operator) of the above-described  
well, being first duly sworn on oath, says: That I have knowledge of the facts, statements, and matters herein contained and the log of the  
above-described well as filed and that the same are true and correct. So help me God.

(Signature)

1432 Wichita Plaza, Wichita, Kansas 67202


(Address)

16 day of November 1973

August 26, 1977

Arlene L. Sloop

Notary Public.

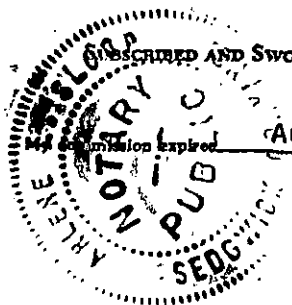

NO. 3 LOVE-NELIAWell Record:

Location: App. C. S/2 S/2 SW/4  
Section 9-30S-2W  
Sumner County, Kansas

Operator: Messman-Rinehart Oil Company  
518 Petroleum Building  
Wichita, Kansas

Contractor: Messman-Rinehart Oil Company  
518 Petroleum Building  
Wichita, Kansas

Casing Record: 8-5/8" @ 250' w/150 sx. cement  
4-1/2" @ 3115' w/60 sx. cement

Commenced: December 3, 1959

Completed: December 13, 1959  
(Rotary)

Elevation: 1331' K/B

Production: Oil

--- L O G ---

Sand, Shale & Shells	590
Lime & Shale	1380
Shale	1660
Shale & Lime	2015
Lime & Shale	2285
Sand	2325
Lime & Shale	2370
Lime	2444
Lime	2470
Lime & Shale	2625
Shale & Lime	2720
Lime & Shale	2880
Shale	3015
Shale & Lime	3060
Lime	3115 R.T.D.

RECEIVED  
STATE CORPORATION COMMISSION  
NOV 19 1973  
CONSERVATION DIVISION  
Wichita, Kansas

Sample Tops:

3044' - Kansas City (-1713)

The undersigned, MESSMAN-RINEHART OIL COMPANY, hereby certifies that the above log is a true and correct log of the formation encountered in drilling the above well as reflected by the Daily Drilling Reports.

MESSMAN-RINEHART OIL COMPANY

By: J. A. Gilliland

J. A. Gilliland

Subscribed and sworn to before me  
this 18th day of March, 1960

Barbara J. Scott  
Barbara J. Scott, Notary Public

My Commission Expires: December 1, 1960