


STATE OF KANSAS  
STATE CORPORATION COMMISSION

WELL PLUGGING RECORD

Give All Information Completely  
Make Required Affidavit  
Mail or Deliver Report to  
Conservation Division  
State Corporation Comm.  
245 North Water  
Wichita, KS 67202

Meade County, Sec. 9 Twp. 32 Rge. 30 ~~EXW~~  
Location as "NE/CNW/SW" or footage from lines  
NE SE NW  
Lease Owner Calvin Exploration, Inc.  
Lease Name Richardson Well No. 1-9  
Office Address 1125-17th St. Suite 2000, Denver, Colorado  
Character of Well (Completed as Oil, Gas or Dry Hole) dry hole

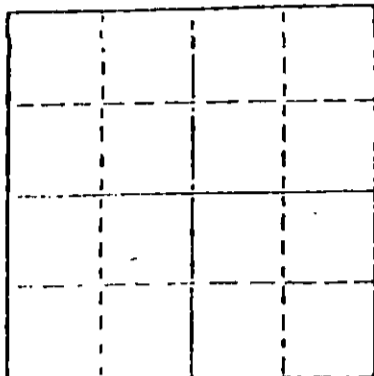

Locate well correctly on above Section Plot

Date Well completed 11-19 1980  
Application for plugging filed 11-18 1980  
Application for plugging approved 11-19 1980  
Plugging commenced 11-19 1980  
Plugging completed 11-19 1980  
Reason for abandonment of well or producing formation dry

If a producing well is abandoned, date of last production 19

Was permission obtained from the Conservation Division or its agents before plugging was commenced? yes

Name of Conservation Agent who supervised plugging of this well Clarence Thomas  
Producing formation \_\_\_\_\_ Depth to top \_\_\_\_\_ Bottom \_\_\_\_\_ Total Depth of Well 5800  
Show depth and thickness of all water, oil and gas formations.

OIL, GAS OR WATER RECORDS

CASING RECORD

FORMATION	CONTENT	FROM	TO	SIZE	PUT IN	PULLED OUT
	Surface Casing	0	1650	8 5/8	1650	none

Describe in detail the manner in which the well was plugged, indicating where the mud plug was placed and the method or methods used in introducing it into the hole. If cement or other plugs were used, state the character of same and depth placed, from \_\_\_\_\_ feet to \_\_\_\_\_ feet for each plug set.

Plugged at 1680 feet with 60 sacks cement  
750 feet with 25 sacks cement  
40 feet with 10 sacks cement,  
5 sacks in rat hole.

Job completed at 4:45 AM on November 19, 1980

RECEIVED  
STATE CORPORATION COMMISSION  
DEC 1 1980

CONSERVATION DIVISION  
Wichita, Kansas 12-1-80

(If additional description is necessary, use BACK of this sheet)

Name of Plugging Contractor Search Drilling

STATE OF Kansas COUNTY OF Sedgwick, ss.  
N. J. Johnson (employee of owner) or (owner or operator)  
of the above-described well, being first duly sworn on oath, says: That I have knowledge of the facts, statements, and matters herein contained and the log of the above-described well is filed and that the same are true and correct. So help me God.

(Signature) N. J. Johnson  
Wichita, Kansas

(Address)  
SUBSCRIBED AND SWORN TO before me this 25th day of November, 1980.  
Maxine Dressen  
Maxine Dressen Notary Public.

My commission expires February 22, 1981



DRILLERS LOG

RICHARDSON 1-9

CASING RECORD:  
8 5/8" set at 1650'  
w/850 sacks cement

OPERATOR: Calvin Exploration, Inc.

DESCRIPTION:

CONTRACTOR: Search Drilling Co.

NE SE NW  
Section 9-32S-30W  
Meade County,  
Kansas

TOTAL DEPTH:

COMMENCED: November 8, 1980

5800'

COMPLETED: November 19, 1980

<u>FORMATION</u>	<u>FROM</u>	<u>TO</u>	<u>REMARKS</u>
Sand and Clay	0	311	
Sand	311	432	
Sand and Red Bed	432	1013	
Lime and Red Bed	1013	1605	
Lime	1605	1760	
Lime and Shale	1760	5800	
Total Rotary Depth	5800		D&A

I certify that this is a true and correct copy of the above log to the best of my knowledge.

SEARCH DRILLING CO.

*N. J. Johnson*  
N. J. Johnson

RECEIVED  
STATE COMMISSION

DEC - 1 1980

CONSERVATION DIVISION  
Wichita, Kansas

Subscribed and sworn to before me this 25th day of November, 1980.

My appointment expires:  
February 22, 1981

*Maxine Dressen*  
Maxine Dressen Notary Public

