


STATE OF KANSAS
STATE CORPORATION COMMISSION
CONSERVATION DIVISION
P. O. BOX 17027
WICHITA, KANSAS 67217

FORM CP-4

WELL PLUGGING RECORD

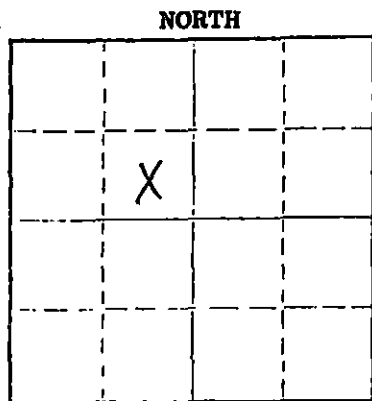

Locate well correctly on above Section Plat

Meade County, Sec. 7 Twp. 32S Rgs. 30 (E) (W) X
Location as "NE/CNW/SE/SW" or footage from lines C SE NW
Lease Owner Sidwell Oil & Gas
Lease Name Mitchell Well No. 2
Office Address Box 2475 Pampa, Texas 79065
Character of Well (completed as Oil, Gas or Dry Hole) Gas
Date well completed 8-2 19 75
Application for plugging filed 4-11 19 77
Application for plugging approved 4-19 19 77
Plugging commenced 4-25 19 77
Plugging completed 4-27 19 77
Reason for abandonment of well or producing formation to a point below economic limits Production declined
If a producing well is abandoned, date of last production 3-22 19 77
Was permission obtained from the Conservation Division or its agents before plugging was commenced? Yes

Name of Conservation Agent who supervised plugging of this well Clarence Thomas
Producing formation St. Louis Depth to top 5812 Bottom 6045 Total Depth of Well 6155 Feet
Show depth and thickness of all water, oil and gas formations.

OIL, GAS OR WATER RECORDS				CASING RECORD		
FORMATION	CONTENT	FROM	TO	SIZE	PUT IN	PULLED OUT
St. Louis	gas, salt, water & oil	5880	5885	8 5/8 4 1/2	1710 6154	none 2710

Describe in detail the manner in which the well was plugged, indicating where the mud fluid was placed and the method or methods used in introducing it into the hole. If cement or other plugs were used, state the character of same and depth placed, from _____ feet to _____ feet for each plug set.

Pump 2 sks. of hulls & 20 sks. of cement from 5880 to 5700
Pump 35 sks. of cement from 1500 to 1400
Put 15 sks. of cement from 40 to 0
RECEIVED
STATE CORPORATION COMMISSION
MAY 17 1977
5-17-77
CONSERVATION DIVISION
Wichita, Kansas

(If additional description is necessary, use BACK of this sheet)
Name of Plugging Contractor Sargents Casing Pulling Service Kansas No. 511
Address Box 506 Liberal, Kansas 67901

STATE OF TEXAS COUNTY OF GRAY ss.
Sidwell Oil & Gas, Inc. (employee of owner) or (owner or operator) of the above-described

well, being first duly sworn on oath, says: That I have knowledge of the facts, statements, and matters herein contained and the log of the above-described well as filed and that the same are true and correct. So help me God.

(Signature) [Signature]
P. O. Box 2475, Pampa, TX 79065
(Address)

Subscribed and sworn to before me this 12th day of May, 19 77

My commission expires 6-1-77 [Signature] Notary Public.

WELL LOG

COMPANY Sidwell Oil & Gas Company

SEC. 7 T. 32S R. 30W

FARM Mitchell

NO. 2 (Washdown)

LOC. C SE NW


TOTAL DEPTH 6,155'

COUNTY Meade

COMM. 6-28-75

COMP. 6-30-75

CONTRACTOR Zenith Drilling Corporation, Inc.

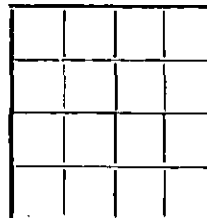

CASING

8-5/8" @ 1710' w/700 sacks cement

4 1/2" @ 6155' w/200 sacks cement

ELEVATION

PRODUCTION

FIGURES INDICATE BOTTOM OF FORMATIONS

New Information

0	1700	Cement & Mud
1700	6155	Mud

Old Information

Was Cleary Petroleum, Inc. - Mitchell #1

Commenced	6- 4-68
Completed	7-11-68
T.D.	6500'

RECEIVED
STATE CORPORATION COMMISSION
APR 11 1977
CONSERVATION DIVISION
Wichita, Kansas

State of Kansas }
County of Sedgwick } as

I, C. Robert Buford of Zenith Drilling Corporation, Inc.

upon oath state the above and foregoing is a true and correct copy of the log of the Mitchell #2 (Washdown) well.

C. Robert Buford

Subscribed and sworn to before me this 9th day of July 19 75

My Commission Expires: August 15, 1975

Myrna D. Murphy
NOTARY PUBLIC
Myrna D. Murphy