


STATE OF KANSAS
STATE CORPORATION COMMISSION

WELL PLUGGING RECORD

Give All Information Completely
Make Required Affidavit
Mail or Deliver Report to:
Conservation Division
State Corporation Commission
212 No. Market
Wichita, Kansas

Meade County. Sec. 7 Twp. 32S Rge. (E) 30 (W)
Location as "NE/CNW/SW" or footage from lines SE NW
Lease Owner Cleary Petroleum, Inc.
Lease Name Mitchell Well No. 1-7
Office Address 310 Kermac Building
Character of Well (completed as Oil, Gas or Dry Hole) dry hole
Date well completed June 23 19 68
Application for plugging filed June 25 19 68
Application for plugging approved June 26 19 68
Plugging commenced June 24 19 68
Plugging completed June 25 19 68
Reason for abandonment of well or producing formation dry hole

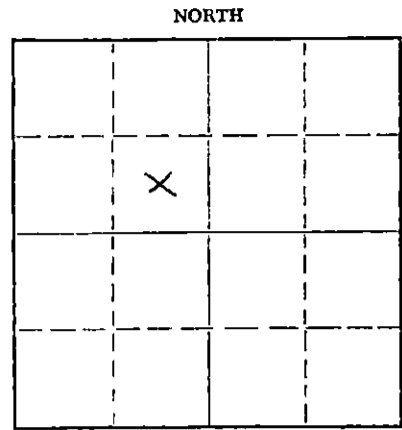

Locate well correctly on above
Section Plat

If a producing well is abandoned, date of last production 19
Was permission obtained from the Conservation Division or its agents before plugging was commenced? yes

Name of Conservation Agent who supervised plugging of this well Mr. EDGAR EVES
Producing formation _____ Depth to top _____ Bottom _____ Total Depth of Well _____ Feet
Show depth and thickness of all water, oil and gas formations.

OIL, GAS OR WATER RECORDS

CASING RECORD

FORMATION	CONTENT	FROM	TO	SIZE	PUT IN	PULLED OUT
Morrow	gas & water	5484	5510	8-5/8	1710	None
St. Louis	gas & water	5870	5927			
St. Louis	oil & water	5970	6045			

Describe in detail the manner in which the well was plugged, indicating where the mud fluid was placed and the method or methods used in introducing it into the hole. If cement or other plugs were used, state the character of same and depth placed, from _____ feet to _____ feet for each plug set.

Set 35 sack plug from 900' to 806'. Set 15 sack plug from 45' to surface.
Cut off 8-5/8" surface casing and weld plate 2' below ground level.

RECEIVED
STATE CORPORATION COMMISSION
JUL 12 1968
CONSERVATION DIVISION
Wichita, Kansas

(If additional description is necessary, use BACK of this sheet)

Name of Plugging Contractor Halliburton Co.
Address Kermac Building, Oklahoma City, Oklahoma

STATE OF Oklahoma, COUNTY OF Oklahoma, ss.
Jack H. Landrum (employee of owner) or (owner or operator) of the above-described

well, being first duly sworn on oath, says: That I have knowledge of the facts, statements, and matters herein contained and the log of the above-described well as filed and that the same are true and correct. So help me God. CLEARY PETROLEUM, INC.

(Signature) Jack H. Landrum
310 Kermac Building, Oklahoma City, Oklahoma
(Address)

SUBSCRIBED AND SWORN TO before me this 11 day of July, 19 68

Phyllis J. Taylor
Phyllis J. Taylor
Notary Public.

My commission expires October 16, 1970

15-119-20023-0000

RECEIVED
STATE CORPORATION COMMISSION
JUL 8 1968
CONSERVATION DIVISION
Wichita, Kansas

SE NW
SECTION 7-32S-30W
MEADE COUNTY, KANSAS

MITCHELL WELL NO. 1

CONTRACTOR: RINE DRILLING COMPANY, INC.

STARTED: JUNE 4, 1968

COMPLETED: JUNE 23, 1968

L O G

Sand & Clay	0'	-	1370'
Red Bed & Anhydrite	1370'	-	2310'
Anhydrite & Shale	2310'	-	2915'
Lime	2915'	-	3714'
Lime & Chalk	3714'	-	4034'
Lime	4034'	-	4158'
Lime & Chalk	4158'	-	4357'
Lime	4357'	-	5510'
Lime & Shale	5510'	-	5560'
Lime	5560'	-	6150'


Totco - 1/4° @ 190'
 Ran total 60 jts. 8 5/8 2 jts. 8rd.
 24# on bottom 57 jts. 32# 10rd. 1jts
 24 8rd. 10rd. set @ 1710' cem. w/20'
 sx. reg. 2% cc 700 sx. Poz 2% cc 2%
 gel.
 Totco - 3/4° @ 2639'
 T.D.-Plug w/35 sx. reg. @ 900'. Plug
 w/15 sx. @ 45.

STATE OF KANSAS)
COUNTY OF SEDGWICK) ss

I, R. M. Green, do hereby certify that the above is a true and accurate log of the Mitchell Well No. 1, located SE of NW of Section 7-32S-30W, Meade County, Kansas.


R. M. Green, Secretary-Treasurer

Subscribed and sworn to before me this 27th day of June, 1968.


Loren E. Lake, Notary Public

My Commission Expires: 6/14/70.