


Give All Information Completely
Make Required Affidavit
Mail or Deliver Report to
Conservation Division
State Corporation Commission

WELL PLUGGING RECORD

P. O. Box 17027
Wichita, Kansas 67217
NORTH

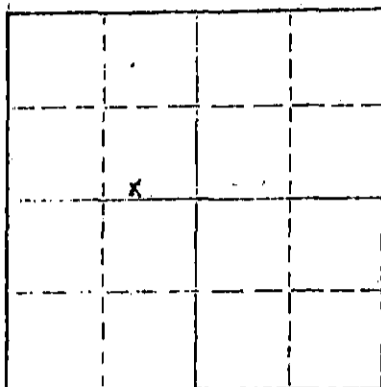

Locate well correctly on above
Section Plat

Meade County, Sec. 6 Twp. 32S. Rge 30 (W)
Location as "NE/CNWSW" or footage from lines 230' NSL & 1680' EWL of NW/4
Lease Owner Sidwell Oil & Gas, Inc.
Lease Name Twist Well No. 1
Office Address P. O. Box 2475, Pampa, Tex 79065
Character of Well (completed as Oil, Gas or Dry Hole) dry hole
Date well completed 9/1/74 19
Application for plugging filed 8/31/74 19
Application for plugging approved 8/31/74 19
Plugging commenced 8/31/74 19
Plugging completed 9/1/74 19
Reason for abandonment of well or producing formation

If a producing well is abandoned, date of last production 19
Was permission obtained from the Conservation Division or its agents before plugging was commenced?

Name of Conservation Agent who supervised plugging of this well
Producing formation Depth to top Bottom Total Depth of Well 6101 Feet
Show depth and thickness of all water, oil and gas formations.

OIL, GAS OR WATER RECORDS

CASING RECORD

| FORMATION | CONTENT | FROM | TO | SIZE | PUT IN | PULLED OUT |
|-----------|---------|------|----|--------|--------|------------|
| | | | | 8 5/8" | 1551' | |
| | | | | | | |
| | | | | | | |
Describe in detail the manner in which the well was plugged, indicating where the mud fluid was placed and the method or methods used in introducing it into the hole. If cement or other plugs were used, state the character of same and depth placed, from feet to feet for each plug set.
1st plug: 35 sx 800/700'
2nd plug: 15 sx 45/0'

RECEIVED
STATE CORPORATION COMMISSION
SEP 9 1974
CONSERVATION DIVISION
Wichita, Kansas

Name of Plugging Contractor Zenith Drilling Corporation, Inc. (If additional description is necessary, use BACK of this sheet)
Address Suite 600, 200 W. Douglas, Wichita, Kansas 67202

STATE OF Kansas, COUNTY OF Sedgwick, ss.
C. Robert Buford (employee of owner) or (owner or operator) of the above-described

well, being first duly sworn on oath, says: That I have knowledge of the facts, statements, and matters herein contained and the log of the above-described well as filed and that the same are true and correct. So help me God.

(Signature) C. Robert Buford
200 W. Douglas Suite 600, Wichita, Kansas (Address)

Subscribed and sworn to before me this 5th day of September, 19 74

My commission expires August 15, 1975
Myrna D. Murphy Notary Public

WELL LOG

COMPANY SIDWELL OIL & GAS, INC.
P. O. Box 2475, Pampa, Texas 79065

SEC. 6-32S-30W

FARM Twist NO. 1

LOC. 230' NSL & 1680 EWL of NW/4


TOTAL DEPTH 6101'

COUNTY Meade County, Kansas

COMM. Aug. 17, 1974 COMP. Sept 1, 1974

CONTRACTOR Zenith Drilling Corp., Inc.
Suite 600, 200 W. Douglas, Wichita, Ks

CASING
1551' 8 5/8" 24# set w/550 sx. cement

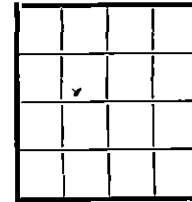

ELEVATION

PRODUCTION D & A

FIGURES INDICATE BOTTOM OF FORMATIONS

- 0 - 45 Surface soil & sand
- 45 - 260 Sand & gravel
- 260 - 400 Sand & redbed
- 400 - 1595 Redbed
- 1595 - 3102 Sand, shale & Lime
- 3102 - 3385 Lime & shale w/sand streaks
- 3385 - 3990 Lime & shale
- 3990 - 5043 Lime
- 5043 - 5126 Lime & shale
- 5126 - 5440 Lime
- 5440 - 5573 Lime & shale
- 5573 - 5760 Lime
- 5760 - 5816 Lime & shale
- 5816 - 5875 Lime
- 5875 - 6101 Lime & shale T. D.

RECEIVED
STATE CORPORATION COMMISSION
SEP 9 1974
CONSERVATION DIVISION
Wichita, Kansas

State of Kansas }
County of Sedgwick } ss

I, C. Robert Buford, President of Zenith Drilling Corporation, Inc.

upon oath state the above and foregoing is a true and correct copy of the log of the Twist #1 well.

C. Robert Buford
C. Robert Buford

Subscribed and sworn to before me this 5th day of September, 1974.

My Commission Expires: Aug. 15, 1975

Myrna D. Murphy
Myrna D. Murphy
NOTARY PUBLIC